


KANSAS Woodson County

FORM 51 5M PETROL

Section 3 -- Township 24 Range 15E

Well No. 5 Switzer

Company C. R. Nigh etal

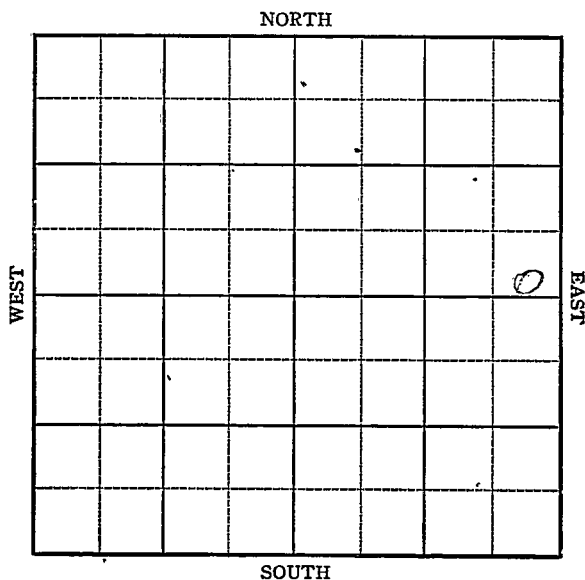

**KANSAS**

Woodson

Sec. 3 Twp. 24 R. 15E

Well No. 5 Switzer Farm

C. R. Nigh et al Company

**Miscellaneous**


\_\_\_\_\_ Ft. from N. Line

220 Ft. from S. Line

220 Ft. from E. Line

\_\_\_\_\_ Ft. from W. Line

SE NE

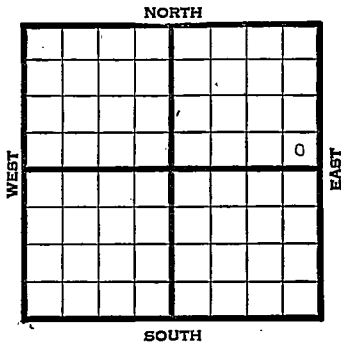

**1945 REPORT**

- 6/6 - Machine
- 6/14 " "
- 6/21 Spud -
- 6/28 10" @ 23  
Drlg. 610
- 7/3 8" @ 786'  
Drlg. 1200'
- 7/11 1235' SD
- 7/19 " "
- 7/26 Drlg. 1400
- 8/1 Drlg. 1400
- 8/8 Miss. 1490  
6" @ 1492  
TD 1536 SD
- 8/15 " "
- 8/22 " "
- 8/29 " "
- 9/5 Drlg. 1755
- 9/12 5" @ 1796  
Drlg. 1830
- 9/19 Arb. 1886  
TD 1890' HFW

**ABANDONED**

Kansas Pool Name Miscellaneous

Map No. 17 Sec. 3 Twp. 24 R. 15E

Well No. 5 Switzer

C. R. Nigh et al Company

**FIRST REPORT**

Contractor

SE NE

**SECTION PLAT**


\_\_\_\_\_ Ft. from N. Line

220 Ft. from S. Line

220 Ft. from E. Line

\_\_\_\_\_ Ft. from W. Line

Woodson County

Location \_\_\_\_\_

Rig up \_\_\_\_\_

Drilling and Remarks:  
**machine**

**RECORD**

Cased \_\_\_\_\_ in., \_\_\_\_\_ ft.

Sand \_\_\_\_\_

Gas \_\_\_\_\_

Oil \_\_\_\_\_

Total Depth \_\_\_\_\_

**PRODUCTION**

1st 24 hrs. Nat. \_\_\_\_\_

1st 24 hrs. after shot \_\_\_\_\_

Gas \_\_\_\_\_ Cu. Ft.

Dry Hole \_\_\_\_\_

Abandoned \_\_\_\_\_

Date

JUN 6 1945 19

S. J. LEWIS Scout

KANSAS

Kansas

Pool Name MiscellaneousMap No. 17 Sec. 3 Twp. 24 R. 15EWell No. 5 SwitzerC. R. Nigh etal CompanyABANDONED Contractor

SE NE

## SECTION PLAT


         Ft. from N. Line220 Ft. from S. Line220 Ft. from E. Line         Ft. from W. LineWoodson CountyLocation         Rig up         

Drilling and Remarks:

CR 1886AFW

## RECORD

Cased          in.,          ft.Sand         Gas         Oil         Total Depth 1890

## PRODUCTION

1st 24 hrs. Nat.         1st 24 hrs. after shot         Gas          Cu. Ft.Dry Hole         Abandoned         

Date

SEP 19 194519S. J. LEWISScout