


Butler

KANSAS

SECTION 18 TOWNSHIP 28 RANGE 8E

WELL NO. #1 Squier

COMPANY Augusta Oil

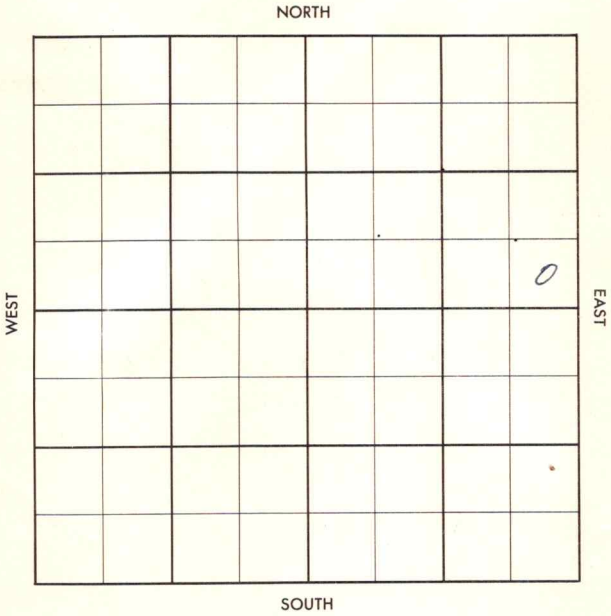

Butler

KANSAS

SEC. 18	TWP. 28	R. 8E
------------	------------	----------

WELL NO.

#1 Squier

FARM

COMPANY

Augusta Oil

CONTRACTOR

WILDCAT


Ft. from N. Line

Ft. from S. Line

Ft. from E. Line

Ft. from W. Line

SE SE NE

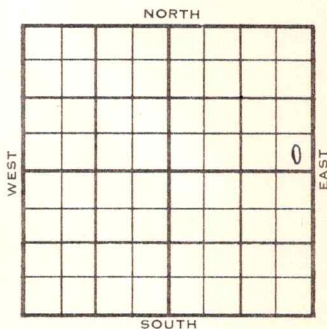1956
###

ELEVATION

1565

REPORT

4-4

Comm. 3-29-56

8" @ 48 w/40

Drlg. 2110

L. 2004

4-11

D & A

M. 2763

TD 2810

ABANDONED

County Butler Elev. 1565
 Sec. 18 Twp. 28 Rge. 8E
 Company Augusta Oil
 Farm Name Squier No. 1

TOPS	DEPTH	LOG	DATUM	Loc. in Sec.
Anh.				SE SE NE
TP.				
H.				
Tr.				
Dg.				
BL.				
L.	2004			Geol.
K.C.				Contr.
B.K.C.				
Ce.				
C.				
M.				
M.				Pool
K.				Wildcat
Mz.				
Mq.				
V.				
S.				
S.				
A.				
R.				
PE.				
G.				
T.D.				

FIRST REPORT
 APR 4 56

Date Comm. 3-29-56
8" @ 48/40 drlg. 2110

County Butler Elev. 1565 Co. Co.
 Sec. 18 Twp. 28 Rge. 8E
 Company Antusta Oil
 Farm Name Squier No. 1

TOPS	DEPTH	LOG	DATUM
Anh.			
TP.			
H.			
Tr.			
Dg.			
BL.			
L.	<u>2004</u>		<u>439</u>
K.C.			
B.K.C.			
Ce.			
C.			
M.	<u>2763</u>		<u>1198</u>
M.			
K.			
Mz.			
Mq.			
V.			
S.			
S.			
A.			
R.			
PE.			
G.			
T.D.	<u>2810</u>		

Loc. in Sec. SE SE NE

Geol. _____

Contr. _____

Pool _____

Wildcat



Date Comm. 3-29-56

APR 1 1 1956

8" @ 48/40

D & A

Co.

Lse.

No.

Sec.

T.

R.