
KANSAS

FORM 51 25M 8-50 WESTERN Woodson

Section 4 Township 24 Range 15 E

Well No. # 1 Vinne

Company E. E. Kilby

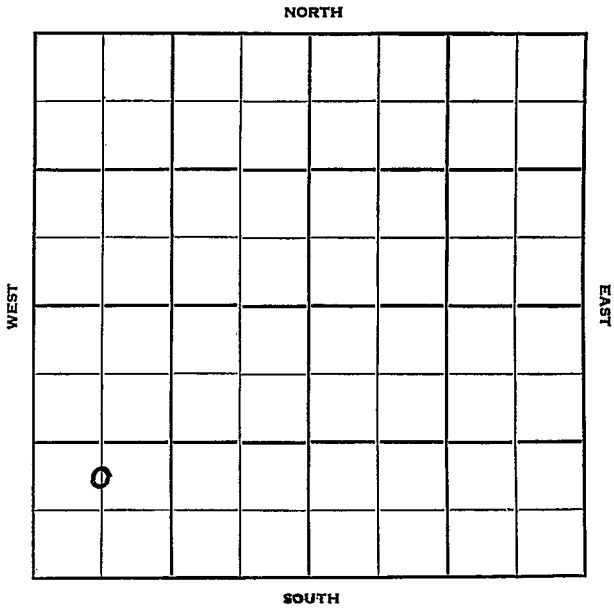

FORM 252-B
10M 8-51 TPCO.

Woodson

KANSAS

Sec. 4 Twp. 24 R. 15E

Well No. #1 Vinne Farm

E. E. Kilby Company

Kilby Contractor


Ft. from N. Line

990 Ft. from S. Line

Ft. from E. Line

660 Ft. from W. Line

C N L SW SW

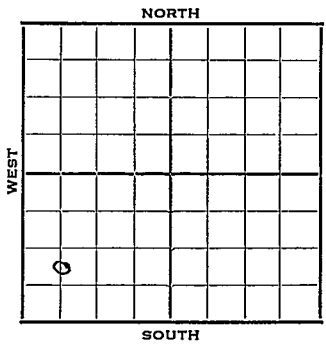

1952

Elev. -

REPORT

6/11 Spud 6-7-52
Lans. 362'
Drlg. 600'

7/2 Spud 6-7-52
Oil well TD 1590' Lans. 362'
8" @ 889 6" @ 1125 TD 1590'
Miss 1577' 5" @ 1570 CO to 1590
PB 1586 2000 A $\frac{1}{4}$ MCFG
Comp. 48 BOPD 100 BW

COMPLETED

FORM 275 FOR SALE BY KANSAS BLUE PRINT CO


County Woodson State KANSAS

Sec. 4 (Blk. Twp.) 24 (Sur. Rge.) 15E Map No.

Operator E. E. Kilby

Well No. 1 Farm Vinne

Elev. Location C N L SW SW

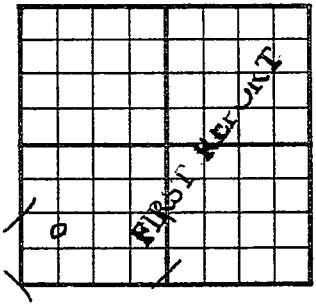

990 Ft. From S Line SW

660 Ft. From W Line Quarter

1st. Report JUN 11 1952

Completion

Remarks

Kilby - Contr.

Spudding Date 6-7-52

Drlg. Data

Lans. 362 drlg. 600

J. G. McGEHEE

FORM 275 FOR SALE BY KANSAS BLUE PRINT CO.


County Woodson State Kansas

Sec. 4 (Blk. Twp.) 24 (Sur. Rge.) 15E Map No.

Operator E. E. Kilby

Well No. 1 Farm Vinne

Elev. Location C N L SW SW

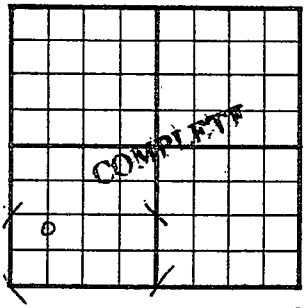

990 Ft. From S Line SW

660 Ft. From W Line Quarter

1st. Report

Completion 1111 2 1952

Remarks

Kilby - Contr.

Spudding Date 6-7-52

Drlg. Data Oil well TD 1590

Lans. 362 8" @ 889 6" @ 1125

TD 1590 Miss. 1577 5" @ 1570

CO to 1590 PB 1586 2000 A $\frac{1}{4}$ mcfg

Comp. 48 bopd 100 bw

J. G. McGEHEE