


Section 16 Township 28 Range 8E

Well No. #3 Fouts

Company K.T. Weidemann

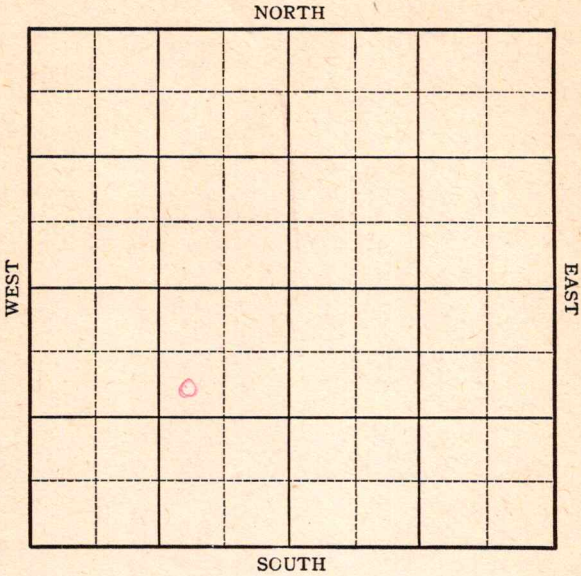

Sec. 16 Twp. 28 R. 8E

Well No. #3 Fouts Farm

K.T. Weidemann Company

Miscellaneous


990 Ft. from N. Line

 Ft. from S. Line

990 Ft. from E. Line

 Ft. from W. Line

SW NE SW

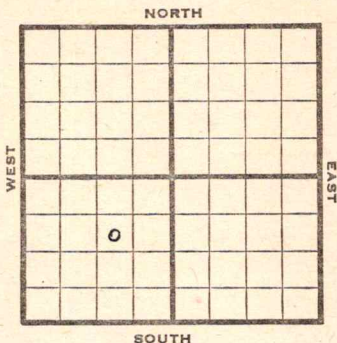

1945

R E P O R T

3/14	R	U	R
3/23	10"	@	23'
	Drlg.		270'
3/29	Drlg.		2200
4/5	Drlg.		2730'
4/12	Miss		2754
	7"	@	2823
	TD		2845 RUST
4/20	"	"	" "
4/27	"	"	" "
5/3	"	"	" "
5/10	"	"	" "
5/17	"	"	" "
5/24	"	"	" "
6/31	"	"	" "
6/8	"	"	" "
6/14	"	"	" "
6/21	"	"	" "
6/28	"	"	" "
7/3	"	"	" "
7/11	"	"	" "
7/19	"	"	" "
7/26	"	"	" "
8/1	"	"	" "
8/8	"	"	" "
8/15	"	"	" "
8/22	"	"	" "
8/29	"	"	" "
9/5	"	"	" "

OVER

2492A

1945

9/12	Miss. 2754		
	7" @ 2823		
	TD 2845'	RUST	
9/19	"	"	"
9/26	"	"	"
10/3	"	"	"
10/10	"	"	"
10/17	"	"	"
10/24	"	"	"
10/31	"	"	"
11/7	"	"	"
11/14	"	"	"
11/21	"	"	"
11/28	"	"	"
12/5	"	"	"
12/12	"	"	"
12/20	"	"	"
12/29	"	"	"

1946

1/9	Miss. 2754		
	7" @ 2823		
	TD 2845		

ABANDONED

Pool Name Miscellaneous

Map No. 10 Sec. 16 Twp. 28 R. 8E

Well No. 3 Fouts

K. T. Weidemann Company

FIRST REPORT Contractor

SW NE SW

SECTION PLAT

990 Ft. from N. Line

 Ft. from S. Line

990 Ft. from E. Line

 Ft. from W. Line

Butler

Location

Rig up

Drilling and Remarks:

RUR

RECORD

Cased in., ft.

Sand

Gas

Oil

Total Depth

PRODUCTION

1st 24 hrs. Nat.

1st 24 hrs. after shot

Gas Cu. Ft.

Dry Hole

Abandoned

Date

MAR 14 1945 19

S. J. LEWIS Scout

KANSAS

Kansas Pool Name Miscellaneous

Map No. 10 Sec. 16 Twp. 28 R. 8E

Well No. 3 Fouts

K. T. Weidemann Company

ABANDONED Contractor

SW NE SW

SECTION PLAT

990 Ft. from N. Line

 Ft. from S. Line

~~990~~ Ft. from E. Line

 Ft. from W. Line

Butler County

Location

Rig up

Drilling and Remarks:

*Mis 2957
7" @ 2823*

RECORD

Cased in., ft.

Sand

Gas

Oil

Total Depth 2845

PRODUCTION

1st 24 hrs. Nat.

1st 24 hrs. after shot

Gas Cu. Ft.

Dry Hole

Abandoned

Date

JAN 9 1946 19

S. J. LEWIS Scout