


Section 6 Township 24 Range 15-E

Well Number 1 Guy

Company Katz et al

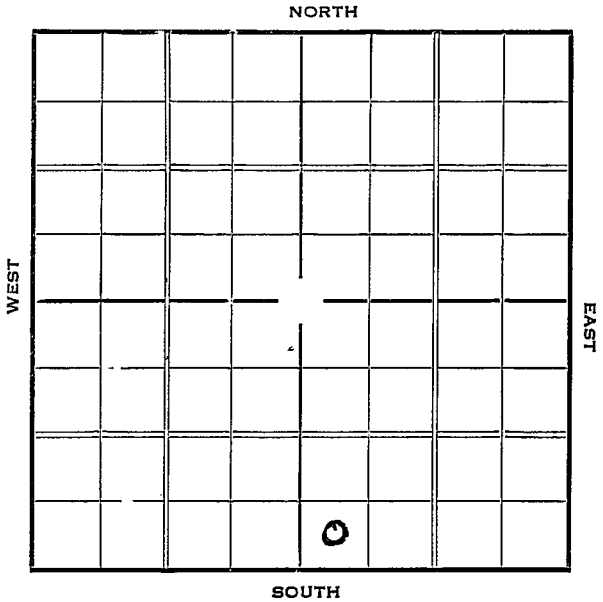

Sec. 6 Twp. 24 R. 15-E

Well No. #1 Guy Farm


Katz et al Company

         Ft. from N. Line

330 Ft. from S. Line

         Ft. from E. Line

330 Ft. from W. Line

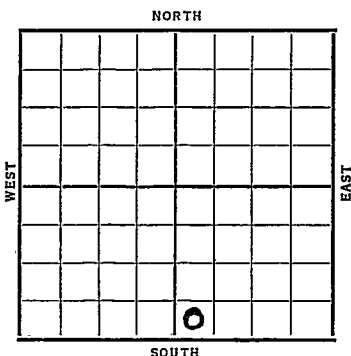

Date	REPORT
1937	
3/31	Spud
4/8	Drlg. 500'
4/16	Fsg. 500'.
4/23	10" @ 640'. Drlg. 750'.
4/30	Reaming 8" @ 1122'.
5/7	8" @ 1124'. Drlg. 1530'.
5/14	Miss. 1545'. 6" @ 1548'.
	2 BW 1602'.
	SD 1643'.
5/19	Miss. 1545'.
	T.D. 1643'.
	<b>ABANDONED</b>

KANSAS *Wadson*

Map No. \_\_\_\_\_ Sec. 6 Twp. 24 R 15E

Well No. 1 Guy

Katz & Hal Company

Contractor

SECTION PLAT


\_\_\_\_\_ Ft. from N. Line

330 Ft. from S. Line

\_\_\_\_\_ Ft. from E. Line

330 Ft. from W. Line

FIRST REPORT

Location \_\_\_\_\_

Rig up \_\_\_\_\_

Drilling and Remarks:

*Spud.*

RECORD

Cased \_\_\_\_\_ in. \_\_\_\_\_ ft.

Sand \_\_\_\_\_

Gas \_\_\_\_\_

Oil \_\_\_\_\_

Total Depth \_\_\_\_\_

PRODUCTION

1st 24 hrs. Nat. \_\_\_\_\_

1st 24 hrs. after shot \_\_\_\_\_

Gas \_\_\_\_\_ Cu. Ft.

Dry Hole \_\_\_\_\_

Abandoned \_\_\_\_\_

Date

**WAR 31 1937** 19

S. J. LEWIS

Scout

**KANSAS**

*Woodson*

Map No. 17 Sec. 6 Twp. 24 R. 15 <sup>E</sup>

Well No. 1 - Guy

Katz et al (Ks. O. & G.) Company

Contractor

**COMPLETED**

**SECTION PLAT**

\_\_\_\_\_ Ft. from N. Line

330 Ft. from S. Line

\_\_\_\_\_ Ft. from E. Line

330 Ft. from W. Line


Location \_\_\_\_\_

Rig up \_\_\_\_\_

Drilling and Remarks:

*DVA*

**RECORD**

Cased \_\_\_\_\_ in., \_\_\_\_\_ ft.

Sand MISS - 1545

Gas \_\_\_\_\_

Oil \_\_\_\_\_

Total Depth 164 3/4

**PRODUCTION**

1st 24 hrs. Nat. \_\_\_\_\_

1st 24 hrs. after shot \_\_\_\_\_

Gas \_\_\_\_\_ Cu. Ft.

Dry Hole \_\_\_\_\_

Abandoned \_\_\_\_\_

Date

**MAY 19 1937** 19

**H. D. Hatfield**

Scout