

KANSAS


FORM 51 5M BR1X

Butler

Section 20 Township 28 Range 8E

Well No. #1 Nelson

Company K T Weidemann

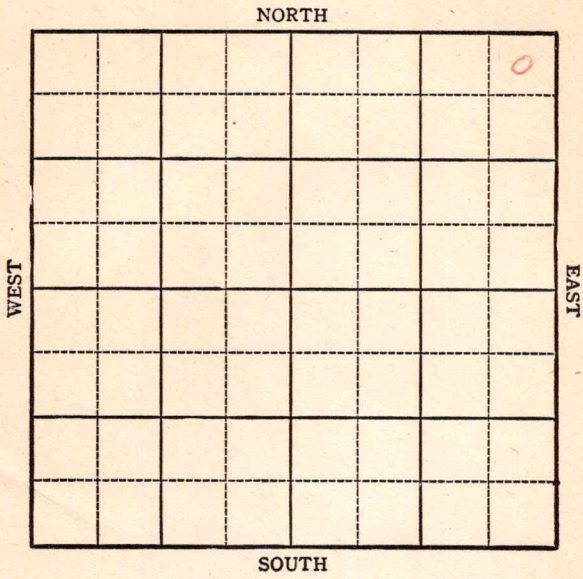

**KANSAS**

Butler

Sec. 20 Twp. 28 R. 8E

Well No. #1, Nelson Farm

K. T. Weidemann Company


Miscellaneous

330 Ft. from N. Line

         Ft. from S. Line

330 Ft. from E. Line

         Ft. from W. Line

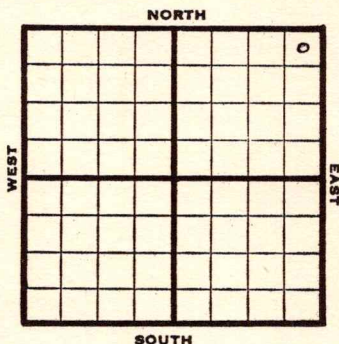

1944

REPORT

6.14 Cellar

6/21 "

6/28 Drlg 160'

7/12 12" @ 850 Drlg 1400

7/19 10" @ 1281

8" @ 1493

Drlg 1561

7/26 **KC 1980** 7" @ 2181 RUST

8/2 **Miss. 2714**

Run 5"

8/9 **Miss. 2730** Corrected

5" @ 2731 TD 2761 CO

8/16 Drlg. 3020

8/23 " "

8/30 PB 2735

6" @ 2728 WQC

9/8 " " " "

9/13 " " " "

9/21 " " " "

9/28 " " " "

10/4 " " " "

10/11 " " " "

10/18 " " " "

10/25 TD 2739 SO

11/1 TD 2743 SW PB

11/8 " " " "

**OVER**

1944

11/15 Miss 2730'  
5" @ 2731  
TD 3026


ABANDONED

Pool Name Miscellaneous**KANSAS**Map No. 18 Sec. 20 Twp. 28 R. 8EWell No. 1 NelsonK.T. Weidemann

Company

**FIRST REPORT**

Contractor

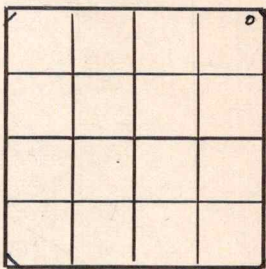NE/C**SECTION PLAT**330 Ft. from N. Line       Ft. from S. Line330 Ft. from E. Line       Ft. from W. LineButler CountyLocation                                 Rig up                                 

Drilling and Remarks:

**Cellar****RECORD**Cased            in.,            ft.Sand                                 Gas                                 Oil                                 Total Depth                                 **PRODUCTION**1st 24 hrs. Nat.                                 1st 24 hrs. after shot                                 Gas                                  Cu. Ft.Dry Hole                                 Abandoned                                 

Date

JUN 14 1944 19**S. J. LEWIS**

Scout

Pool Name MiscellaneousMap No. 10 Sec. 20 Twp. 28 R. 8EWell No. 1 NelsonK. T. Weidemann CompanyABANDONED

Contractor

NE/c

## SECTION PLAT

|  |  |  |   |
|--|--|--|---|
|  |  |  | 6 |
|  |  |  |   |
|  |  |  |   |
|  |  |  |   |
|  |  |  |   |

330 Ft. from N. Line       Ft. from S. Line330 Ft. from E. Line       Ft. from W. LineButler CountyLocation                     Rig up                     

Drilling and Remarks:

*Miss 2780*  
*5' 02781*

## RECORD

Cased            in.,            ft.Sand                     Gas                     Oil                     Total Depth 3026

## PRODUCTION

1st 24 hrs. Nat.                     1st 24 hrs. after shot                     Gas                      Cu. Ft.Dry Hole                     Abandoned                     

Date

NOV 15 1944

19

S. J. LEWIS

Scout