


Section 21 Township 28 Range 8E

Well No. #24 Ferrell

Company Table Mesa Oil

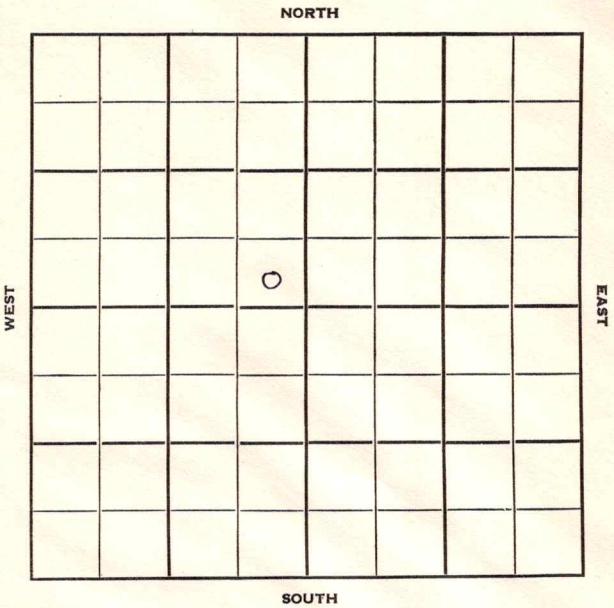

Sec. 21 Twp. 28 R. 8E

Well No. #24 Ferrell Farm \_\_\_\_\_

Table Mesa Oil Company \_\_\_\_\_


Ferrell Pool Contractor \_\_\_\_\_

\_\_\_\_\_ Ft. from N. Line

330' Ft. from S. Line

330' Ft. from E. Line

\_\_\_\_\_ Ft. from W. Line

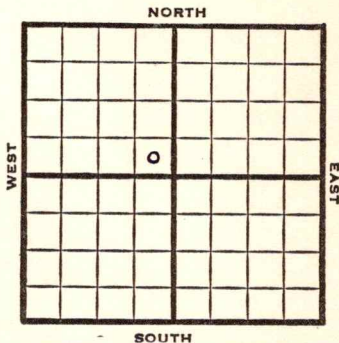

SE SE NW

1951

Elev. -

REPORT

9/12  
10/17

Location  
 Spud 9-19-51  
 Oil well TD 2750  
 10"@ 57  
 Miss 2726-35  
 Miss. dol. 2735-48  
 3000 A  
 TD 2750  
 Comp. 25 BOPD

**COMPLETED**



County Butler State Kansas

Sec. 21 (Blk. 28) (Sur. 8E) Map No.

Operator Table Mesa

Well No. 24 Farm Ferrell

Elev. Location SE SE NW


330 Ft. From S Line NW

330 Ft. From E Line Quarter

Ist. Report

Completion OCT 17 1951

Remarks Ferrell Pool

Rex & Morris - Contr.

Spudding Date 9-19-51

Drlg. Data Oil well TD 2750

10" @ 57 Miss. 2726-35 Miss. dol. 2735-

48 3000 A TD 2750 Comp. 25 bopd

J. E. TYRA