Butler


KANSAS

FORM 51 5M BRIX

Section 21 Township 28 Range 8E

Well No. #1 Ferrel Ranch

Company Wixson et al

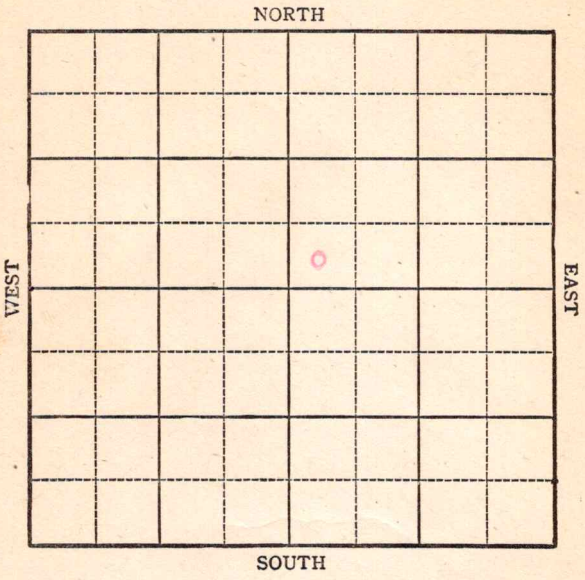

FORM 252-A
5M 9-44 PETROL

Butler


KANSAS

Sec. 21 Twp. 28 R. 8E

Well No. #1 Ferrel Ranch Farm

Wixson et al Company

Miscellaneous

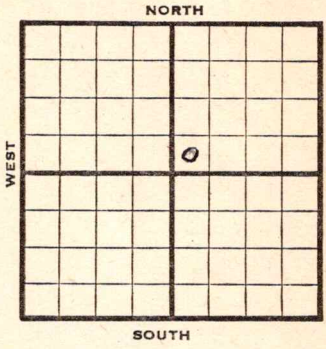

_____ Ft. from N. Line

330 Ft. from S. Line

_____ Ft. from E. Line

330 Ft. from W. Line

SW NE

1945	REPORT
1/31	Location
2/7	"
2/14	Mach
2/21	Drlg 200
2/28	300 SD
3/7	Drlg 1000
3/14	12" @ 1005 Drlg 1350
3/23	10" @ 1590 Drlg. 1450'
3/29	10" @ 1540 Lans 1670 Drlg. 1800
4/5	8" @ 2075 Drlg. 2300'
4/12	5" @ 2706' WOC
4/20	Miss 2704-43 TD 600' oil
4/27	Est. 20 a day Nat. 2000 acid.
5/2	Miss 2704 5" @ 2706 TD 2743 2000 acid. Pump 20 Pot. Grav. 39.0

COMPLETED

FORM 26 200 BKS. 2-44 PETROL

KANSAS

Pool Name Miscellaneous

Map No. K-10 Sec. 21 Twp. 28 R. 8E


Well No. 1 Ferrel Ranch

Wixson etal Company

FIRST REPORT Contractor

SW NE

SECTION PLAT

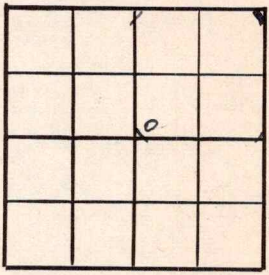

Ft. from N. Line

330 Ft. from S. Line

Ft. from E. Line

330 Ft. from W. Line

Butler

Location X

Rig up

Drilling and Remarks:

RECORD

Cased in., ft.

Sand

Gas

Oil

Total Depth

PRODUCTION

1st 24 hrs. Nat.

1st 24 hrs. after shot

Gas Cu. Ft.

Dry Hole

Abandoned

Date

JAN 31 1945 19 S. J. LEWIS Scout

FORM 26 200 BKS 1-44 PETROL

Kansas Pool Name Miscellaneous

Map No. 10 Sec. 21 Twp. 28 R. 8E


Well No. 1 Ferrel Ranch

Wixson etal Company

COMPLETED Contractor

SW NE

SECTION PLAT

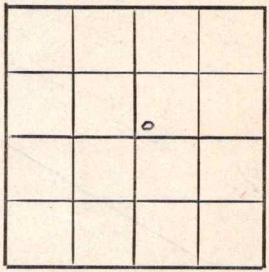

____ Ft. from N. Line

330 Ft. from S. Line

330 Ft. from E. Line

____ Ft. from W. Line

Butler County

Location

Rig up

Drilling and Remarks:

Miss 2704

5" @ 2706

2000 Acid

Pump 20 BH

39° Gr

RECORD

Cased ____ in., ____ ft.

Sand

Gas

Oil

Total Depth 2743

PRODUCTION

1st 24 hrs. Nat.

1st 24 hrs. after shot

Gas ____ Cu. Ft.

Dry Hole

Abandoned

Date

MAY 2 1945 19

S. J. LEWIS Scout