KANSAS


FORM 51 5M 10-41 PETROL Butler

Section 21 Township 28 Range 8-E

Well No. #9 Ferrell Ranch

Company Table Mesa Oil

Miscellaneous

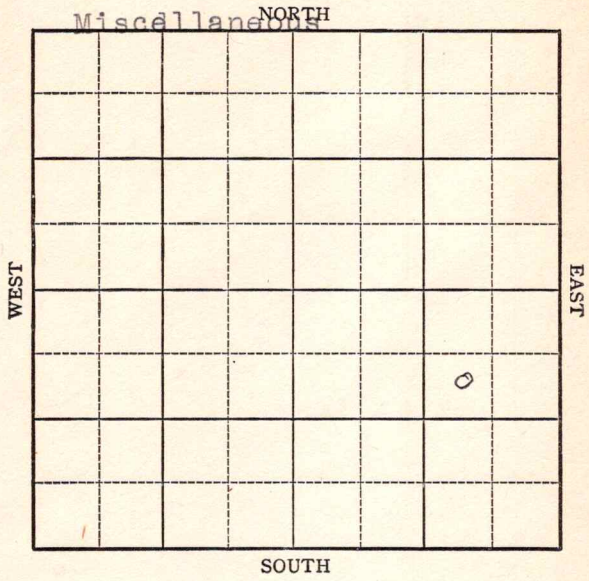

Form 252-A
5M 5-42 Petrol

KANSAS Butler

Sec. 21 Twp. 28 R. 8-E

Well No. #9 Ferrell Ranch Farm

Table Mesa Oil Company


(Miscellaneous)

1016 Ft. from N. Line

Ft. from S. Line

1016 Ft. from E. Line

Ft. from W. Line

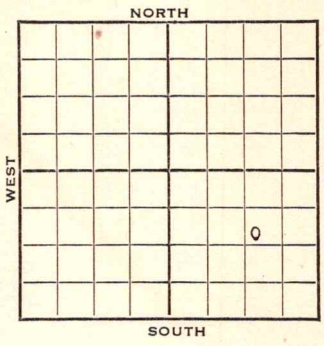

1942	REPORT
7/29	Location
8/5	"
8/12	Cable rig
8/19	" "
8/27	" "
9/2	" "
9/9	" "
9/16	" "
9/30	" "
10/7	12" - 935 - Drlg. 1102'
10/14	10" @ 1171 Drlg. 1205'
10/21	10" @ 1283 Drlg 1295'
10/28	Sand 1580 8" @ 1600 Drlg. 1716
11/4	Drlg. 1720
11/11	Drlg. 1920'
11/18	Oswego 2106 -12 TD 6" @ 2095 SD

OVER

1942
11/24 TD 6" @ 2095 SO

12/2 Drlg. 2580

12/9 Miss 2596
TD 2639
5" @ 2620
WOC

12/16 " "

12/22 Shut down

12/29 "

1943
1/6 T. D. 2639'SD

1/13 Pump 50 bbls oil plus water.

1/20 Miss 2596
5" Casing set 2620'
Pump 12 Pot.
27 Gravity.
TD 2639'

COMPLETED

Form 26 200 Bks. 5-41 McW.

Butler KANSAS

Map No. 10 Sec. 21 Twp. 28 R. 8E

Well No. 9 Ferrell Ranch

Table Mesa Oil Company

FIRST REPORT Contractor

SW NE SE


1016 Ft. from N. Line

Ft. from S. Line

1015 Ft. from E. Line

Ft. from W. Line

SECTION PLAT

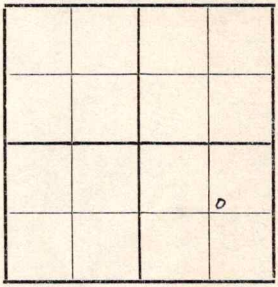

MISCELLANEOUS

Location XXX

Rig up

Drilling and Remarks:

RECORD

Cased in., ft.

Sand

Gas

Oil

Total Depth

PRODUCTION

1st 24 hrs. Nat.

1st 24 hrs. after shot

Gas Cu. Ft.

Dry Hole

Abandoned

Date

JUL 29 1942 19 S. J. LEWIS Scout

Form 26 200 Bks 5-42 Petrol

KANSAS

Butler

Map No. 10 Sec. 21 Twp. 28 R. 8E

Well No. 9 Ferrell Ranch

Table Mesa Oil Company

COMPLETED Contractor

SW NE SE


1016 Ft. from N. Line

Ft. from S. Line

1015 Ft. from E. Line

Ft. from W. Line

SECTION PLAT

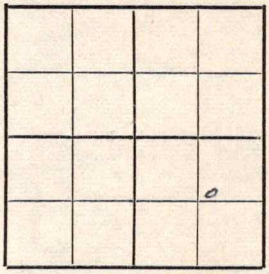

MISCELLANEOUS

Location

Rig up

Drilling and Remarks:

Miss 2596

5" @ 2620

Pump 12 BO

23° Gr

RECORD

Cased in., ft.

Sand

Gas

Oil

Total Depth 2638

PRODUCTION

1st 24 hrs. Nat.

1st 24 hrs. after shot

Gas Cu. Ft.

Dry Hole

Abandoned

Date

JAN 20 1943 19

S. J. LEWIS Scout