

KANSAS


Butler

Section 21 Township 28 Range 8-E

Well No. #3 Ferrell Ranch

Company Table Mesa Oil

NORTH Ferrell Pool

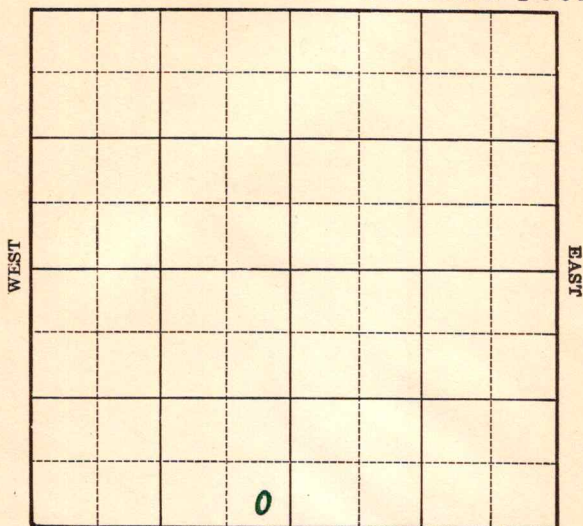

0

SOUTH

KANSAS

Butler

Sec. 21 Twp. 28 R. 8-EWell No. #3 Ferrell Ranch FarmTable Mesa Oil

Company

(Ferrell)

Ft. from N. Line


100

Ft. from S. Line

340

Ft. from E. Line

Ft. from W. Line

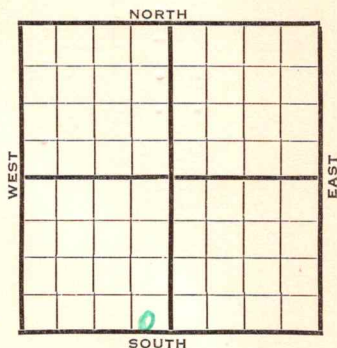

1940

REPORT

7/31

Drlg. 2400'

8/8

Miss. 2691' 6" - 2718'

T.D. 2762' S.O. Shut down.

8/14

S.O. 2705-07

S.O. 2736-38 1½ B.W. 2785-95

Drlg. 2930'

8/22

B. Miss. 2940' Simp. 2990'

Arb. 3030-68' T.D. P.B. 2752'

8/29

7" - 2718' T.D. 2745'

SO & W.

9/5

P.B. 2742'

9/12

500 acid. Jet 1000 acid.

Pump 15 bbls.

OVER

1940
9/18

Miss. 2691'

Arb. 3030'

7" - 2718'

T.D. 3068'

P.B. to 2742'

1500 acid.

Potential 15 bbls., pump.

COMPLETED

Map No. 10 Sec. 21 Twp. 28 R. 8EWell No. 3 Ferrell Ranch

Table Mesa Oil

Company

Contractor

FIRST REPORT

SE SW

 Ft. from N. Line100 Ft. from S. Line340 Ft. from E. Line Ft. from W. Line

SECTION PLAT

	0		

FERRELL POOL

Location Rig up

Drilling and Remarks:

Drlg. 2400

RECORD

Cased in., ft.Sand Gas Oil Total Depth

PRODUCTION

1st 24 hrs. Nat. 1st 24 hrs. after shot Gas Cu. Ft.Dry Hole Abandoned

Date

JUL 31 1940 19

S. J. LEWIS Scout

Map No. 10 Sec. 21 Twp. 28 R. 8EWell No. 3 Ferrell Ranch

Table Mesa Oil

Company

Contractor

COMPLETED

SECTION PLAT

SE SW

_____ Ft. from N. Line

100 Ft. from S. Line340 Ft. from E. Line

_____ Ft. from W. Line

FERRELL POOL

Location _____

Rig up _____

Drilling and Remarks:

*Miss 2691**Er 43030**2" @ 2718**P.B. 2742**1500 ac. abt**Pump 15 P.F.*

RECORD

Cased _____ in., _____ ft.

Sand _____

Gas _____

Oil _____

Total Depth 3068

PRODUCTION

1st 24 hrs. Nat. _____

1st 24 hrs. after shot _____

Gas _____ Cu. Ft.

Dry Hole _____

Abandoned _____

Date

SEP 18 1940 19

S. J. LEWIS Scout