


Ellsworth County Kansas

Form 51-5M 5-37 Petrol

Section 30 Township 17 Range 10W

Well No. 4 Patzner

Company Phillips

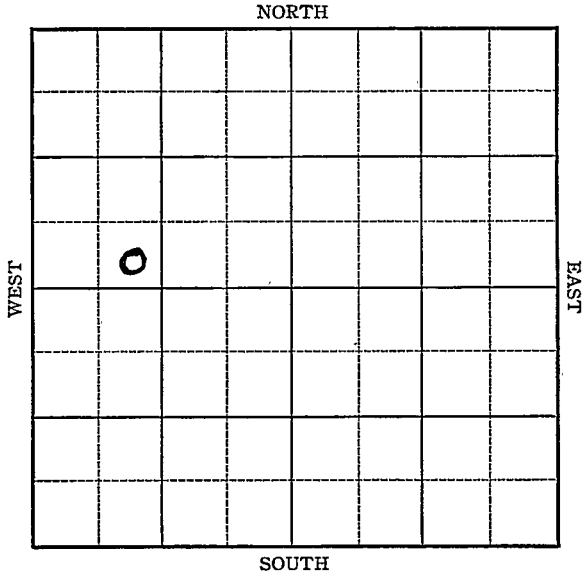

Sec. 30 Twp. 17 R. 10-W

Well No. #4 Patzner Farm


Phillips Company

_____ Ft. from N. Line

330 Ft. from S. Line

_____ Ft. from E. Line

990 Ft. from W. Line

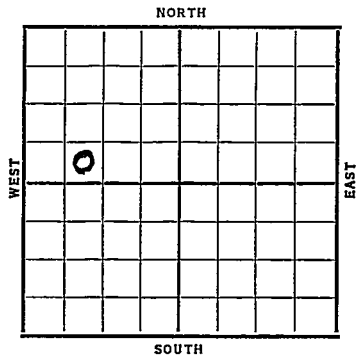

Date	REPORT
1937	
7/28	R. U. R.
8/6	10" @ 190'. Drlg. 1625'.
8/13	Drlg. 2925'.
8/20	" "
8/28	Sil. 3287'. T.D. 3299'.
	1500' oil 6 hrs. 2880' 13 hrs
	Swab 253 bbls. 5 hrs. RUST.
9/3	4000 acid. Pump 255 B.O.
	2 hrs & Broke down.
9/8	7" @ 3287'.
	Sil. 3287'.
	T.D. 3299'.
	4000 acid.
	Pump 418.10 bbls. 4 hrs.
	422 bbls. 4 hrs.
	Potential 2509 bbls.
	COMPLETED

Ellsworth

Map No. 55 Sec. 30 Twp. 17 R. 10W

Well No. 4 - Patzner

Phillips Company

Contractor

FIRST REPORT

SECTION PLAT

_____ Ft. from N. Line

330 Ft. from S. Line

_____ Ft. from E. Line

990 Ft. from W. Line

Location _____

Rig up _____

Drilling and Remarks:

R. U. R.

RECORD

Cased _____ in., _____ ft.

Sand _____

Gas _____

Oil _____

Total Depth _____

PRODUCTION

1st 24 hrs. Nat. _____

1st 24 hrs. after shot _____

Gas _____ Cu. Ft.

Dry Hole _____

Abandoned _____

Date

JUL 28 1937

H. D. Hatfield Scout

Ellsworth

KANSAS

Map No. _____ Sec. 30 Twp. 17 R. 10W

Well No. 4-Patzner
Phillips pet Company _____

Contractor _____

COMPLETED

SECTION PLAT

0			

_____ Ft. from N. Line

330 Ft. from S. Line

_____ Ft. from E. Line

990 Ft. from W. Line

Location _____

Rig up _____

Drilling and Remarks:

4000 acid

Pumps 418, 104 lbs
" 422 " "

Potential

2509 bbls

RECORD

Cased 7 in., 3289 ft.

Sand *silicious* 3287

Gas _____

Oil _____

Total Depth 3299

PRODUCTION

1st 24 hrs. Nat. _____

1st 24 hrs. after shot _____

Gas _____ Cu. Ft.

Dry Hole _____

Abandoned _____

Date

SEP 8 1937 19

H. D. Hatfield

Score