

Section 21 Township 28 Range 8E

Well No. 6 Ferrell Ranch

Company Wixson et al

Misc.

NORTH

WEST

EAST

						○	

SOUTH



Sec. 21 Twp. 28 R. 8-E

Well No. #6 Ferrell Ranch Farm

Wixson et al Company

Miscellaneous


_____ Ft. from N. Line

990' Ft. from S. Line

990' Ft. from E. Line

_____ Ft. from W. Line

NW SE NE

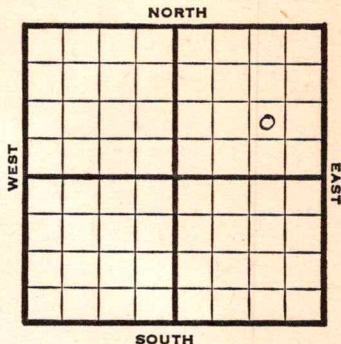

1947

Elev. -

REPORT

11/12

Drlg. 400'

11/19

12" @ 865'
Drlg. 1100'

11/25

Drlg. 1520'

12/3

Drlg. 1610'

12/10

8" @ 1725' Drlg. 2075

12/17

Drlg. 2490'

1948

1/7

Chat 2660'
Total Depth 2693'

ABANDONED

Map No. _____ Sec. 21 Twp. 28 R. 8E

Well No. 6 Ferrell Ranch

Wixson etal. Company

FIRST REPORT Contractor

NW SE NE

SECTION PLAT

			0

_____ Ft. from N. Line

990 Ft. from S. Line

990 Ft. from E. Line

_____ Ft. from W. Line

Butler County

Location _____

Rig up _____

Drilling and Remarks:

drilg. 400

RECORD

Cased _____ in., _____ ft.

Sand _____

Gas _____

Oil _____

Total Depth _____

PRODUCTION

1st 24 hrs. Nat. _____

1st 24 hrs. after shot _____

Gas _____ Cu. Ft.

Dry Hole _____

Abandoned _____

Date

NOV 1 2 1947 19

S. J. LEWIS Scout

Map No. 10 Sec. 21 Twp. 28 R. 8E

Well No. 6 Ferrell Ranch

Wixson etal. Company

ABANDONED Contractor

NW SE NE

SECTION PLAT

			o

_____ Ft. from N. Line

990 Ft. from S. Line

990 Ft. from E. Line

_____ Ft. from W. Line

Butler County

Location _____

Rig up _____

Drilling and Remarks:

Chatt 2660

RECORD

Cased _____ in., _____ ft.

Sand _____

Gas _____

Oil _____

Total Depth 2693

PRODUCTION

1st 24 hrs. Nat. _____

1st 24 hrs. after shot _____

Gas _____ Cu. Ft.

Dry Hole _____

Abandoned _____

Date

JAN 7 1948 19

S. J. LEWIS Scout