

STATE CORPORATION COMMISSION OF KANSAS
OIL & GAS CONSERVATION DIVISION

WELL COMPLETION OR RECOMPLETION FORM
ACO-1 WELL HISTORY

DESCRIPTION OF WELL AND LEASE

Operator: license # 5115
name Reese Exploration, Inc.
address P.O. Box 11598
City/State/Zip K. C. Mo. 64138

Operator Contact Person Patty Eichman
Phone 816-356-1970

Contractor: license # 5685
name Michael Drilling

Wellsite Geologist Deacon Geology
Phone 913-272-4383

Complete Type of Completion

☒ New Well☐ Re-Entry☐ Workover☐ Oil☐ SWD☐ Temp Abd☐ Gas☐ Inj☐ Delayed Comp☒ Dry☐ Other (Core, Water Supply etc.)

WFO: old well info as follows:

Operator
Well Name
Comp. Date Old Total Depth

WELL HISTORY

Drilling Method: ☒ Mud Rotary ☐ Air Rotary ☐ Cable

4-23-85 4-25-85 4-25-85
Date Date Reached TD Completion Date

1607'
Total Depth PBD

Amount of Surface Pipe Set and Cemented at 40 feet

Multiple Stage Cementing Collar Used? ☐ Yes ☒ No

If Yes, Show Depth Set feet

Alternate 2 completion, cement circulated

from feet depth to w/ SX cmt

API NO. 15 - 087-20,152

County Jefferson

SE SW NW Sec 19 Twp 9 Rge 20 ☒ East ☐ West
(location)

3140 Ft North from Southeast Corner of Section
4230 Ft West from Southeast Corner of Section
(Note: locate well in section plat below)


Lease Name Wright Well# 1-85

Field Name McLouth NW

Producing Formation n/a

Elevation: Ground 1088 KB

Section Plat

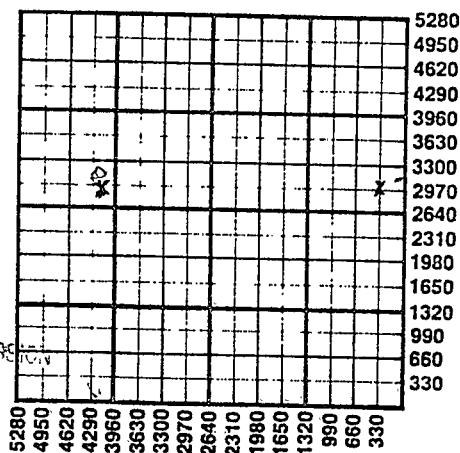

RECEIVED

MAY 28 1985

CONSERVATION DIVISION
Wichita, Kansas

WATER SUPPLY INFORMATION

Source of Water:

Division of Water Resources Permit #

☐ Groundwater Ft North From Southeast Corner and
(Well) Ft West From Southeast Corner of
Sec Twp Rge ☐ East ☐ West

☐ Surface Water Ft North From Southeast Corner and
(Stream, Pond etc.) Ft West From Southeast Corner
Sec Twp Rge ☐ East ☐ West

☐ Other (explain)
(purchased from city, R.W.D.#)

Disposition of Produced Water:

☐ Disposal☐ Repressuring

Docket #

INSTRUCTIONS: This form shall be completed in duplicate and filed with the Kansas Corporation Commission, 200 Colorado Derby Building, Wichita, Kansas 67202, within 90 days after completion or recompletion of any well. Rules 82-3-130 and 82-3-107 apply.

Information on side two of this form will be held confidential for a period of 12 months if requested in writing and submitted with the form. See rule 82-3-107 or confidentiality in excess of 12 months.

One copy of all wireline logs and drillers time log shall be attached with this form. Submit CP-4 form with all plugged wells. Submit CP-111 form with temporarily abandoned wells.

305-P-PI

SIDE TWO

Operator Name Reese Exploration Lease Name Wright Well# 1-85 SEC 19 TWP 9 RGE 20 ☒ East ☐ West

WELL LOG

INSTRUCTIONS: Show important tops and base of formations penetrated. Detail all cores. Report all drill stem tests giving interval tested, time tool open and closed, flowing and shut-in pressures, whether shut-in pressure reached static level, hydrostatic pressures, bottom hole temperature, fluid recovery, and flow rates if gas to surface during test. Attach extra sheet if more space is needed. Attach copy of log.

Drill Stem Tests Taken

Samples Sent to Geological Survey

Cores Taken

☐ Yes

☒ No

☐ Yes

☒ No

☐ Yes

☒ No

Formation Description

☒ Log

☐ Sample

Name

Top

Bottom

Hushpuckney	824	
Marmaton Gp	970	
Cherokee Sh.	1066	
Upr McLouth Sd	1515	
Mid. McLouth Sd	1540	
Lower McLouth	1572	
Mississippian Lm	1580	
TD	1607	

CASING RECORD

☒ new

☐ used

Report all strings set - conductor, surface, intermediate, production, etc.

Purpose of string	size hole drilled	size casing set (In O.D.)	weight lbs/ft.	setting depth	type of cement	# sacks used	type and percent additives
Surface	10-1/2	6-1/4		40'	portland	10	none

PERFORATION RECORD

shots per foot

specify footage of each interval perforated

Acid, Fracture, Shot, Cement Squeeze Record

(amount and kind of material used)

Depth

	n/a	n/a	