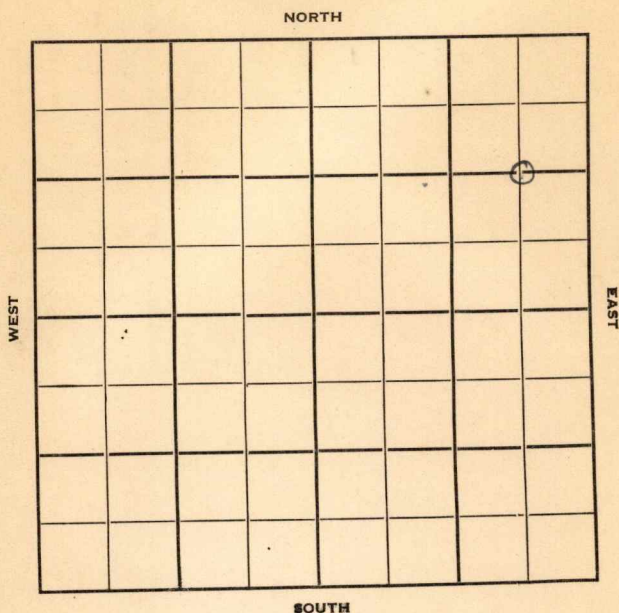


Section 32 Township 28 Range 10-EWell No. #2 SimmonsCompany W M Glasco & Holl

Elk

KANSAS

Sec. 32 Twp. 28 R. 10E

Well No. #2 Simmons Farm

W. M. Glasco & Holl Company

Contractor

Wildcat


1320' Ft. from N. Line

Ft. from S. Line

660' Ft. from E. Line

Ft. from W. Line

C $E\frac{1}{2}$ NE

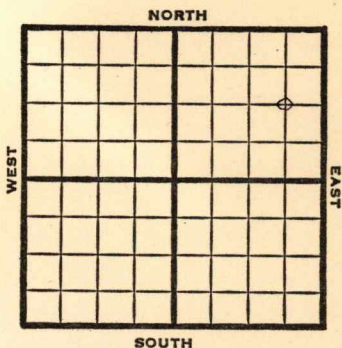

1950

REPORT

4/5

RUR

5/24

TD 1572

8" @ 770

TD 1572 in KC

D&A

ABANDONED


Map No. _____ Sec. 32 Twp. 28 R. 10EWell No. 2 Simmons

_____ W. M. Glasco & Holl _____ Company

_____ Contractor

C E $\frac{1}{2}$ NE

SECTION PLAT

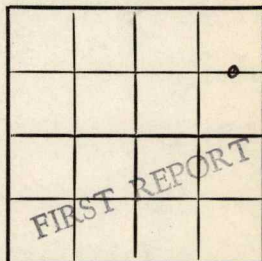1320 Ft. from N. Line

_____ Ft. from S. Line

660 Ft. from E. Line

_____ Ft. from W. Line

Elk County

Location _____

Rig up _____

Drilling and Remarks:

R U R

RECORD

Cased _____ in., _____ ft.

Sand _____

Gas _____

Oil _____

Total Depth _____

PRODUCTION

1st 24 hrs. Nat. _____

1st 24 hrs. after shot _____

Gas _____ Cu. Ft.

Dry Hole _____

Abandoned _____

Date

APR 5 1950

19

J. E. TYRA

Scout

Kansas

Map No. _____ Sec. 32 Twp. 28 R. 10EWell No. 2 SimmonsW. M. Glasco & Holl Company_____
ContractorC E $\frac{1}{2}$ NE

SECTION PLAT

1320 Ft. from N. Line_____
Ft. from S. Line660 Ft. from E. Line_____
Ft. from W. Line

Elk

Location _____

Rig up _____

Drilling and Remarks:

8" c 770

T.D. 1572 in KC.

D + A

RECORD

Cased _____ in., _____ ft.

Sand _____

Gas _____

Oil _____

Total Depth 1572

PRODUCTION

1st 24 hrs. Nat. _____

1st 24 hrs. after shot _____

Gas _____ Cu. Ft.

Dry Hole _____

Abandoned _____

Date

MAY 24 1950

19

J. E. TYRA

Scout