


Section 5 Township 28 Range 11E

Well No. #1 Souder

Company Frame et al

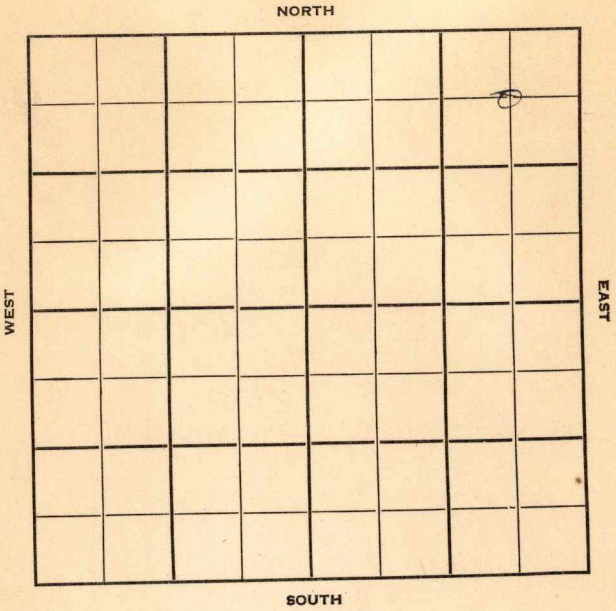

Greenwood

KANSAS

Sec. 5 Twp. 28 R. 11E

Well No. #1 Souder Farm
Frame et al Company


Miscellaneous

660' Ft. from N. Line

_____ Ft. from S. Line

660' Ft. from E. Line

_____ Ft. from W. Line

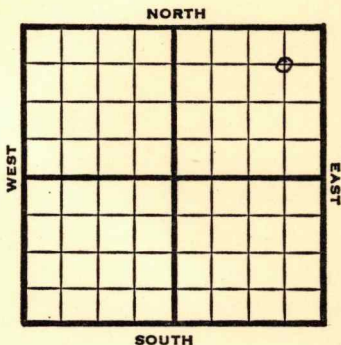

C NE NE

1950

REPORT

1/11 Drlg. 580'

2/8 **KC 1120'**

TD 1260'

P 25 BOPD

Comp

COMPLETED

Kansas

Map No. _____ Sec. 5 Twp. 28 R. 11E

Well No. 1 Souder

_____ Frame etal. _____ Company

_____ Contractor

C NE NE

SECTION PLAT

660 Ft. from N. Line

_____ Ft. from S. Line

660 Ft. from E. Line

_____ Ft. from W. Line

| | | | |
|----------|--|--|---|
| | | | o |
| COMPLETE | | | |
| | | | |
| | | | |

Greenwood County

Location _____

Rig up _____

Drilling and Remarks:

KC 1120
T.D. 1260
P 25 BOPD

RECORD

Cased _____ in., _____ ft.

Sand _____

Gas _____

Oil _____

Total Depth _____

PRODUCTION

1st 24 hrs. Nat. _____

1st 24 hrs. after shot _____

Gas _____ Cu. Ft.

Dry Hole _____

Abandoned _____

Date

FEB 8 1950

19

J. E. TYRA

Scout

Kansas

Map No. _____ Sec. 5 Twp. 28 R. 11E

Well No. 1 Souder

_____ Frame et al. _____ Company

_____ Contractor

C NE NE

SECTION PLAT

660 Ft. from N. Line

_____ Ft. from S. Line

660 Ft. from E. Line

_____ Ft. from W. Line

| | | | |
|--------------|--|--|---|
| | | | O |
| FIRST REPORT | | | |
| | | | |
| | | | |

Greenwood County

Location _____

Rig up _____

Drilling and Remarks:

drlg. 580

RECORD

Cased _____ in., _____ ft.

Sand _____

Gas _____

Oil _____

Total Depth _____

PRODUCTION

1st 24 hrs. Nat. _____

1st 24 hrs. after shot _____

Gas _____ Cu. Ft.

Dry Hole _____

Abandoned _____

Date

JAN 11 1950 19

J. E. TYRA Scout