


Section 5 Township 28 Range 11E

Well No. #2 Sauders

Company Melvin Acheson, Scotts Bluff, Nebr

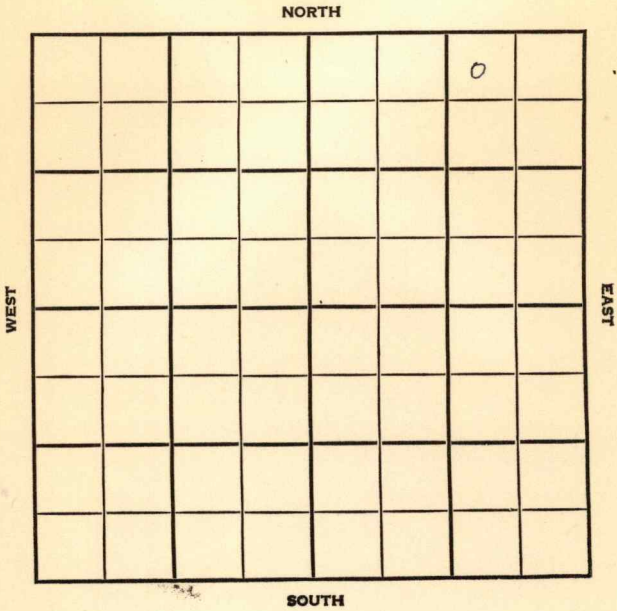

Greenwood

KANSAS

SEC.	TWP.	R.
5	28	11E

WELL NO.

#2 Sauders

FARM

COMPANY

Melvin Acheson, Scotts Bluff, Nebr.

CONTRACTOR

Shira

N. Severy


FT. FROM N. LINE

FT. FROM S. LINE

FT. FROM E. LINE

FT. FROM W. LINE

NW NE NE

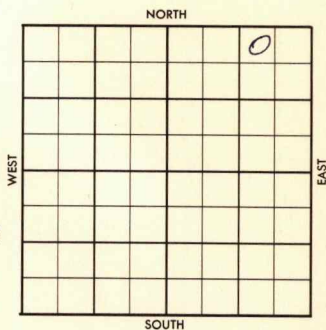

	ELEVATION	REPORT
1956		

8-8

Comm. 8-1-56

8" @ 9 w/10

SO 830-41

4" @ 1327

WOC

KC. 1274';

TD 1328'

8-29

CO 16/1282-84

tst 6 GWPH; / scum oil

PB 900 8/842-44; FU 150' oil / 450' wtr., 1 hr.

P/ 5 BOPD / 150 BWPD.

Tp. 797';

TD 1328'

COMPLETED

County <u>Greenwood</u>				Elev.	Co.
Sec. <u>5</u>	Twp. <u>28</u>	Rge. <u>11E</u>			
Company <u>Melvin Acheson, Scotts Bluff, Nebr.</u>					
Farm Name <u>Sauders</u>				No. <u>2</u>	

TOPS	DEPTH	LOG	DATUM	Loc. in Sec.
Anh.				NW NE NE
Tr.	797			
H.				
Tr.				
Dg.				
BL.				
L.	1274			Geol.
K.C.				Cantr.
B.K.C.				Shira
Ce.				Pool
C.				N. Severy
M.				
M.				
K.				
Mz.				
Ma.				
V.				
S.				
S.				
A.				
R.				
Pe.				
G.				
Tr.	1328			

COMPLETE

Date Comm. 8-1-56 AUG 29 1956

8" @ 9/10 SO 830-41 4" @ 1327

WOC AUG 15 AUG 22 '56 Co 16/1282-84

TSJ 6 Bwpd + scum oil

1B 900 8/842-44 FU 150' oil

+ 450' wtz 1 hr TGR AUG 29 '56

P. 5 Bopd + 150 Bwpd.

County Greenwood Elev. _____
 Sec. 5 Twp. 28 Rge. 11E
 Company Melvin Acheson, Scotts Bluff, Nebr.
 Farm Name Sanders No. 2

TOPS	DEPTH	LOG	DATUM	Loc. in Sec.
Anh.				NW NE NE
Tr.				
H.				
Tr.				
Dg.				
Bl.				
L.				
K.C.	1274			Geol.
B.K.C.				Contr.
Ce.				Shire
C.				Pool
M.				N. Severy
M.				
K.				
Mz.				
Me.				
V.				
S.				
S.				
A.				
R.				
Pe.				
G.				
T.D.	1328			

FIRST REPORT

Date Comm. 8-1-56 AUG 8 '56

8" @ 9/10 SO 830-41 4" @ 1327

WOC

AUG 10 1956

R. C.

34