


Section 8 Township 28 Range 11-E

Well No. 3-K Davis

Company C. C. Whittaker et al

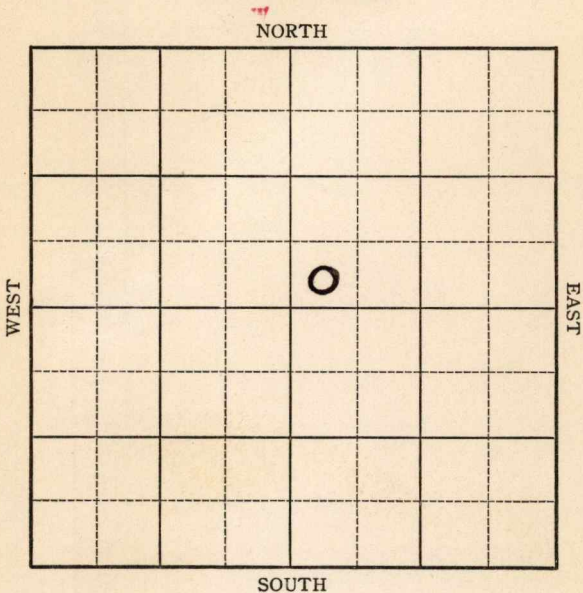

Sec. 8 Twp. 28 R. 11-E

Well No. #3-K Davis Farm


C.C. Whittaker et al Company

 Ft. from N. Line

220 Ft. from S. Line

 Ft. from E. Line

220 Ft. from W. Line

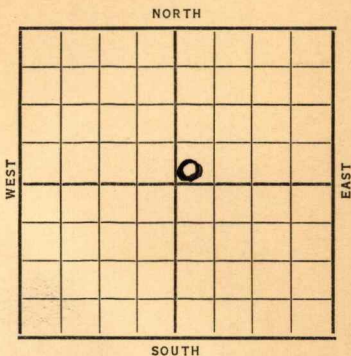

Date	REPORT
1937	
8/4	Machine
8/13	10" @ 314'. C.O.
8/20	Drlg. 500'.
8/28	Good S.O. 755-65'.
	Fsg. 1020'.
9/3	K.C. 1065'. S.O. 1187 & 5".
	Shut down.
9/10	" "
9/17	" "
9/24	T.D. 1215'. C.O.
10/2	" " "
10/6	5" @ 1187'.
	K.C. 1065'.
	T.D. 1225'.
	1000 acid.
	Potential 18 bbls.
	COMPLETED

KANSAS

Form 26—1M Bks.—2-29

Greenwood

Map No. 9 Sec. 8 Twp. 28 R. 11 E

Well No. 3-K-Davis

C.C. Whittaker et al Company

Contractor

FIRST REPORT

SECTION PLAT

_____ Ft. from N. Line

220 Ft. from S. Line

_____ Ft. from E. Line

220 Ft. from W. Line

		0	

Location _____

Rig up _____

Drilling and Remarks:

machine

RECORD

Cased _____ in., _____ ft.

Sand _____

Gas _____

Oil _____

Total Depth _____

PRODUCTION

1st 24 hrs. Nat. _____

1st 24 hrs. after shot _____

Gas _____ Cu. Ft.

Dry Hole _____

Abandoned _____

Date

AUG 4 - 1937

H. D. Hatfield

Scout