


Section 8 Township 28 Range 11-E

Well Number 1 - Miller


Company C. C. Whittaker

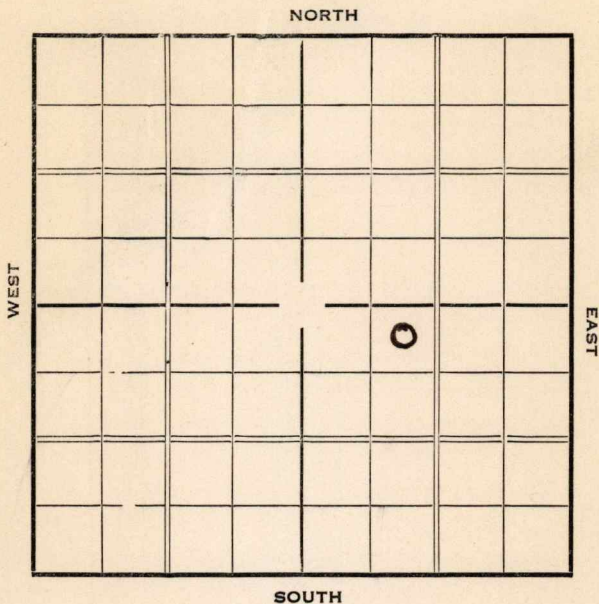

Sec. 8 Twp. 28 R. 11-E

Well No. #1 Miller Farm
C. C. Whittaker Company

330 Ft. from N. Line
 _____ Ft. from S. Line
 _____ Ft. from E. Line
990 Ft. from W. Line

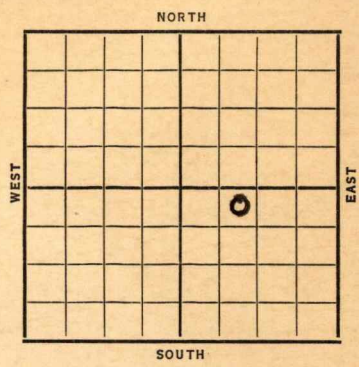

Date	REPORT
1937	
5/5	10" @ 300'. 8" @ 550'.
	K. C. 1170'. 6" @ 1170'.
	T.D. 1172'. C.O.
5/14	6" @ 1176'. T.D. 1227'.
	C.O.
5/21	T.D. 1227'. Acidizing.
5/28	" " " "
6/2	6" @ 1176'.
	K.C. 1170'.
	T.D. 1227'.
	200 acid.
	Pot. 25 bbls.
	COMPLETED

KANSAS

Greenwood

Map No. 9 Sec. 8 Twp. 28 R. 11E

Well No. 1 - Miller

C. C. Whittaker Company

Contractor

FIRST REPORT

SECTION PLAT

330 Ft. from N. Line

 Ft. from S. Line

 Ft. from E. Line

990 Ft. from W. Line

		0	

Location _____

Rig up _____

Drilling and Remarks:

10" - 300

8" - 550

K.C. 1170

6" - 1170

T.D. 1172

C. O.

RECORD

Cased _____ in., _____ ft.

Sand _____

Gas _____

Oil _____

Total Depth _____

PRODUCTION

1st 24 hrs. Nat. _____

1st 24 hrs. after shot _____

Gas _____ Cu. Ft.

Dry Hole _____

Abandoned _____

Date

MAY 5 - 1887

19

H. O. Hatfield Scout

KANSAS *Greenwood*

Map No. 9 Sec. 8 Twp. 28 R. 11E

Well No. 1- Miller

C. C. Whittaker Company

Contractor

COMPLETED

350 Ft. from N. Line
 Ft. from S. Line
 Ft. from E. Line
990 Ft. from W. Line

SECTION PLAT

		0	

Location _____

Rig up _____

Drilling and Remarks:

200 Acid

Pat - 25

RECORD

Cased 6 in., 1176 ft.
Sand KC - 1170
Gas _____
Oil _____
Total Depth 1227

PRODUCTION

1st 24 hrs. Nat. _____
1st 24 hrs. after shot _____
Gas _____ Cu. Ft.
Dry Hole _____
Abandoned _____

Date

JUN 2 1937 19

H. D. Hatfield Scout