

GEOLOGICAL DEPARTMENT
SOUTHWESTERN GAS COMPANY
INDEPENDENCE, KANSAS

25-24-15

Company **Finley et al**

S. T. R. 25-24-15
 County Woodson
 State Kansas
 Lease and Well No. Kads Kads


Contractor **Frank Young, Chanute, Kansas.**

Drilling Commenced _____ Drilling Completed **May, 1925.**

Initial Production **Dry** Initial Rock Pressure _____

Location **SE corner of the NW $\frac{1}{4}$ of the SW $\frac{1}{4}$.**

Casing **30'-10" 600'-8"**
1235'-8"

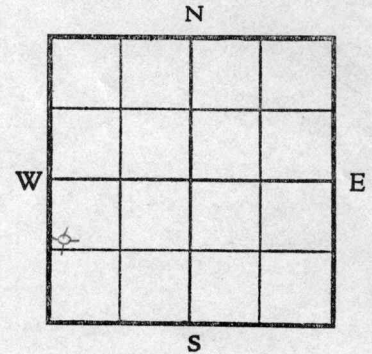

Driller's Record of Formations

35	brown shale	35
2	lime	37
2	shale	39
9	lime	48
32	shale	80
150	blue shale	210
120	lime	330
10	shale	340
65	lime	405
50	shale	455
30	lime	485
68	shale	553
65	lime	618
5	shale muddy	623
30	lime	653
8	shale	661
5	lime	666
3	shale	669
24	sand	693
5	lime	698
77	shale	775 (177)
10	lime	785
65	shale	850
5	lime	855
5	brown lime	860
15	black shale	875
10	lime	885
300	white shale	1185
90	black shale	1275
15	white shale	1290
15	sandy lime	1305
10	flinty lime	1315
7	first break in lime-- sulphur water. pulled and plugged	

This log is exactly as the driller gave us but there seems to be an error of 100' in the depth. H.A.H.