


Map No. Kansas Sec. 25 Twp. 24 R. 15

Well No. 1 Eades Farm
Funley et al Company

NORTH

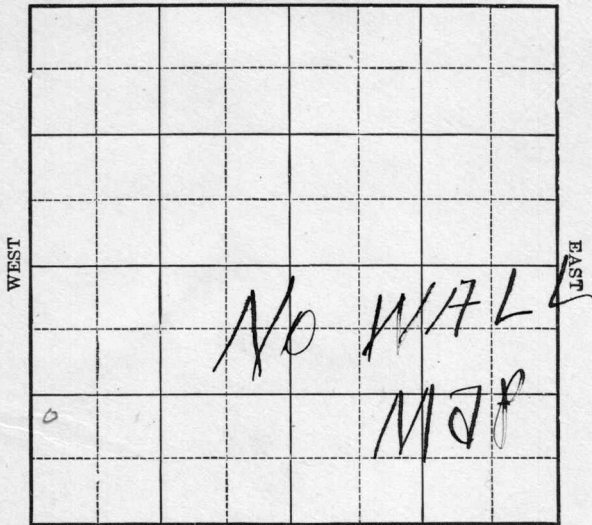

SOUTH

Location _____

Drilling Remarks _____

Rig Up _____

Drilling Remarks _____

RECORD

Cased _____ in. _____ ft.
Sand _____
Gas _____
Oil _____
Total Depth _____

PRODUCTION

1st 24 hrs. Nat. _____
1st. 24 hrs. after shot _____
Gas _____ cu. ft.
Dry Hole _____
Abandoned _____

Map No. 1/4 Sects Sec. 35 Twp. 74 R. 15

Well No. 1 6 ads

Fin by J. A. Company _____

Contractor _____

SECTION PLAT

_____ Ft. from N. Line

1120 Ft. from S. Line

_____ Ft. from E. Line

200 Ft. from W. Line

FIRST REPORTS

Location _____

Rig up _____

Drilling and Remarks:

Only 850'
machine

RECORD

Cased _____ in., _____ ft.

Sand _____

Gas _____

Oil _____

Total Depth _____

PRODUCTION

1st 24 hrs. Nat. _____

1st 24 hrs. after shot _____

Gas _____ Cu. Ft.

Dry Hole _____

Abandoned _____

Date

MAY 8 1925

192

CHAS. L. SHERWOOD

Scout

Map No. 15400 Sec. 25 Twp. 24 R. 15

Well No. 1 6225

Finby Jal Company

Contractor

COMPLETED

SECTION PLAT

----- Ft. from N. Line

1120

----- Ft. from S. Line

----- Ft. from E. Line

200

----- Ft. from W. Line

0			

ABANDONED

Location -----

Rig up -----

Drilling and Remarks:

Tap 1st BW 1437
H 2 W.
Dry & abo.

RECORD

Cased ----- in., ----- ft.

Sand -----

Gas -----

Oil -----

Total Depth 1437

PRODUCTION

1st 24 hrs. Nat. -----

1st 24 hrs. after shot -----

Gas ----- Cu. Ft.

Dry Hole -----

Abandoned -----

Date

JUN 5 1925

192

CHAS. L. SHERWOOD

Scout