


Section 35 Township 24 Range 15-E

Well Number 1 - Koening

Company Morris et al

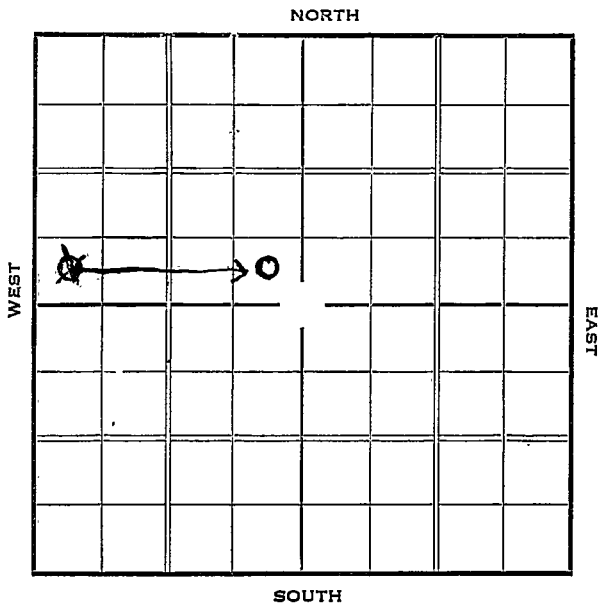

Sec. 35 Twp. 24 R. 15-E

Well No. #1 Koening Farm


Morris et al Company

 Ft. from N. Line

330 Ft. from S. Line

330 Ft. from E. Line

~~550~~ Ft. from W. Line

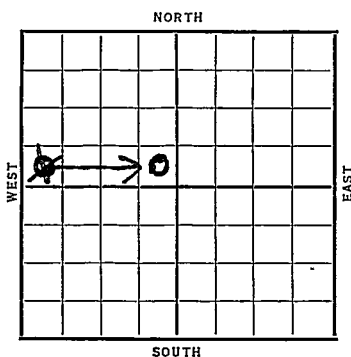

Date	REPORT
1937	
5/26	Drlg. 400'.
6/4	" "
6/11	SD 700'.
6/19	" "
6/25	Drlg. 1050'.
7/2	SD 1231'.
7/9	" "
7/16	" "
7/23	10" @ 833'. Drlg. 1400'.
7/30	Miss. 1422'. H.F.W. 1458'. S.D.O.
8/6	" " " " "
8/13	" " " " "
8/20	" " " " "
8/25	Miss 1422'
	TD 1458'
	HFV
	D&A
	ABANDONED

Woodson **KANSAS**

Map No. 17 Sec. 35 Twp. 24 R. 15E

Well No. 1-Koeling

Morris et al Company

Contractor

FIRST REPORT

_____ Ft. from N. Line

330 Ft. from S. Line

_____ Ft. from E. Line

330 Ft. from W. Line

SECTION PLAT

0			

Location _____

Rig up _____

Drilling and Remarks:

Dlg 400

RECORD

Cased _____ in., _____ ft.

Sand _____

Gas _____

Oil _____

Total Depth _____

PRODUCTION

1st 24 hrs. Nat. _____

1st 24 hrs. after shot _____

Gas _____ Cu. Ft.

Dry Hole _____

Abandoned _____

Date

MAY 26 1937 19

E. D. Hatfield Scout

Map No. 17 Sec. 35 Twp. 24 R. 15^E

Well No. 1-Koenig
Morris et al Company

Contractor

CORRECTION

SECTION PLAT

_____ Ft. from N. Line

330 Ft. from S. Line

330 Ft. from E. Line

_____ Ft. from W. Line

		0	

Location _____

Rig up _____

Drilling and Remarks:

*1st reported
as being in
SW NW*

RECORD

Cased _____ in., _____ ft.

Sand _____

Gas _____

Oil _____

Total Depth _____

PRODUCTION

1st 24 hrs. Nat. _____

1st 24 hrs. after shot _____

Gas _____ Cu. Ft.

Dry Hole _____

Abandoned _____

Date _____

Woodson **KANSAS**

Map No. 17 Sec. 35 Twp. 24 R. 15^E

Well No. 1-Koenig

Morris et al Company

Contractor

ABANDONED

SECTION PLAT

	0		

330 Ft. from N. Line

330 Ft. from S. Line

330 Ft. from E. Line

_____ Ft. from W. Line

Location _____

Rig up _____

Drilling and Remarks:

HFW

DYA

RECORD

Cased _____ in., _____ ft.

Sand MISS 1422

Gas _____

Oil _____

Total Depth 1458

PRODUCTION

1st 24 hrs. Nat. _____

1st 24 hrs. after shot _____

Gas _____ Cu. Ft.

Dry Hole _____

Abandoned _____

Date

AUG 25 1937

19

H. D. Hatfield Scout