



Map No. KANSAS Sec. 7 Twp. 24 R. 14-E


Well No. 10-Smith-Jobe Farm  
Connelly & Cooper Company

660 Ft. from N. Line

         Ft. from S. Line

990 Ft. from E. Line

         Ft. from W. Line

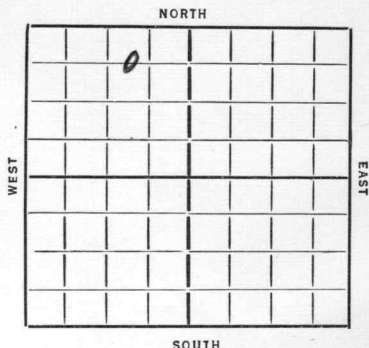

Date  
1936

REPORT

3/25 Top Miss. lime 1690  
 Pay 1723-1733 Estimate 5 bbls.  
 Acidizing T.D. 1736

4/2 --  
4/1 T.L. 1690 TD 1736  
 2000 acid  
 30 bbls.

COMPLETED

Map No. 17 Sec. 7 Twp. 24 R. 14E

Well No. 10 Smith-John

Connelly & Cooper Company

Contractor

SECTION PLAT

	0		

660 Ft. from N. Line

..... Ft. from S. Line

990 Ft. from E. Line

..... Ft. from W. Line

FIRST REPORTS

Location.....

Rig up.....

Drilling and Remarks:

Top. Miss. Lime  
1690.

Pay 1723-1733  
Est 5 1/2 k.

Acidizing

RECORD

Cased.....in., .....ft.

Sand.....

Gas.....

Oil.....

Total Depth 1736

PRODUCTION

1st 24 hrs. Nat.....

1st 24 hrs. after shot.....

Gas..... Cu. Ft.

Dry Hole.....

Abandoned.....

Date

3/25/26 192.....

S. J. LEWIS

Scout

*Woodson*

Map No. 17 Sec. 7 Twp. 24 R. 14E

Well No. 10-Smith Grove

Connelly + Cooper Company

Contractor

COMPLETE

SECTION PLAT

660 Ft. from N. Line

..... Ft. from S. Line

990 Ft. from E. Line

..... Ft. from W. Line

	0		

RECORD

Location.....

Rig up.....

Drilling and Remarks:

*2000 acid*

*30 bfh*

Cased..... in., ..... ft.

Sand TL 1690

Gas.....

Oil.....

Total Depth 1736

PRODUCTION

1st 24 hrs. Nat.....

1st 24 hrs. after shot.....

Gas..... Cu. Ft.

Dry Hole.....

Abandoned.....

Date

4-1-36 192.....

ORVAL MANNSCHRECK

Scout