

Woodson

KANSAS 14E ✓

Sec. 7 Twp. 24 R. _____

Well No. #1 Williams Farm _____

Ray Anderson & Cotton Company _____

Contractor _____

_____ Ft. from N. Line

340


_____ Ft. from S. Line

_____ Ft. from E. Line

340

_____ Ft. from W. Line

SW SW SE (Twin Well)

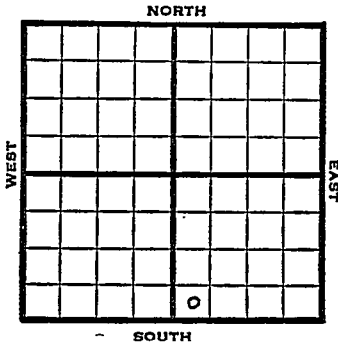

1952

REPORT

10/1

Spud 9-7-52
7" @ 1538 Miss 1665
5" @ 1702 TD 1710
PB 1702 Fishing

10/29

Spud 9-7-52
Oil Well TD 1727'
7" @ 1538'
Miss. 1665
5" @ 1702' TD 1710 PB 1702
Pulled 5" DD 1727'
5" @ 1727' Perf. 1703-15
2000 A Comp. 11 bopd

COMPLETED

