


Section 8 Township 24 Range 11 E

Well No. # 1 Comstock

Company Chas. Theis et al

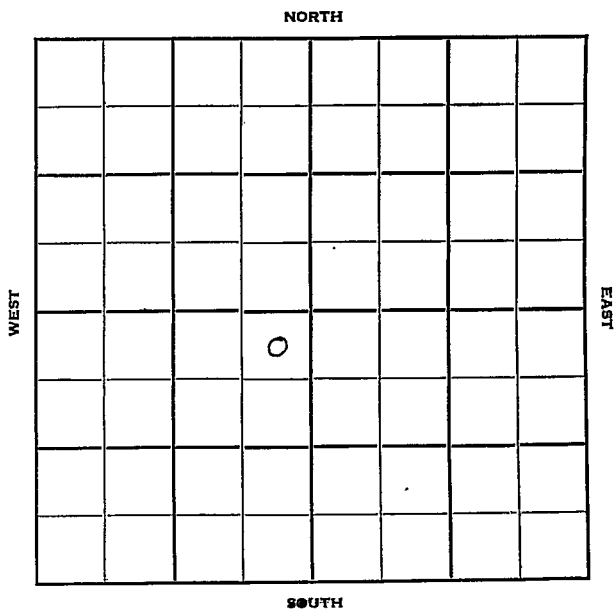

Woodson

KANSAS

Sec. 8 Twp. 24 R. 14 E

Well No. # 1 Comstock Farm

Chas. Theis et al Company

Kilby Contractor


330 Ft. from N. Line

_____ Ft. from S. Line

330 Ft. from E. Line

_____ Ft. from W. Line

NE NE SW

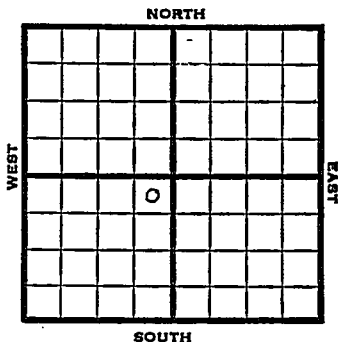

1951

Elev. -

REPORT

5/29

Spud 5-15-51
10" @ 870'
Miss. 1705'
Drlg. 1730'

6/6

Spud 5-15-51 D & A TD 1746'
10" @ 870 Miss 1705' TD 1746' HFW
D & A

ABANDONED

