

Butler

Map No. _____ Sec. 7 Typ. 29 R. 4E

Well No. 1 - Rutherford Farm _____

Booby & Keene Company _____


_____ Ft. from N. Line

100 Ft. from S. Line

100 Ft. from E. Line

_____ Ft. from W. Line

TWIN

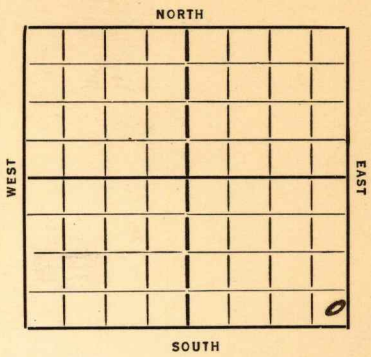

Date 1935

REPORT

11/27 dly 1750
12/6 6" 1760 TD 1830
 Small sho Oil
12/13 T Line + 6" 1800
 20 + g 1815
 dly 1815 sw.
12/19 _____
12/26 TD 1865, PB 1835
 1000 acid Will percidize
1/2/36 2250 acid Estg
1/8 Miss 1800
 TD 1865
 PB 1835
 1000 acid
 2250 ✓
 Est 40 Oil

COMPLETED

KANSAS

Map No. 11 Sec. 7 Twp. 29 R. 4E

Well No. 1 - Rutherford

Sosby & Kane Company

Contractor

FIRST REPORTS

SECTION PLAT

Ft. from N. Line

100 Ft. from S. Line

100 Ft. from E. Line

Ft. from W. Line

			0

Twin

Location

Rig up

Drilling and Remarks:

100g 1750

RECORD

Cased in., ft.

Sand

Gas

Oil

Total Depth

PRODUCTION

1st 24 hrs. Nat.

1st 24 hrs. after shot

Gas Cu. Ft.

Dry Hole

Abandoned

Date

ORVAL MANNSCHRECK

11-27-35 192

Scout

Map No. 11 Sec. 7 Twp. 29 R. 4E

Well No. 1 - Rutherford

Looby & Keene Company

Contractor

SECTION PLAT

..... Ft. from N. Line

330 Ft. from S. Line

330 Ft. from E. Line

..... Ft. from W. Line

COMPLETED

Location.....

Rig up.....

Drilling and Remarks:

P.B. 1835
1000 acid
2250 ✓

Est. 40 oil

RECORD

Cased..... in., ft.

Sand miss 1800

Gas.....

Oil.....

Total Depth 1865

PRODUCTION

1st 24 hrs. Nat.....

1st 24 hrs. after shot.....

Gas..... Cu. Ft.

Dry Hole.....

Abandoned.....

Date

JAN 8 1936

192

ORVAL MANNSCHRECK

Scout