


Section 31 Township 17 Range 10-W

Well No. 3 Patzner "B"

Company Spencer & Yarnell

NORTH Bloomer Pool

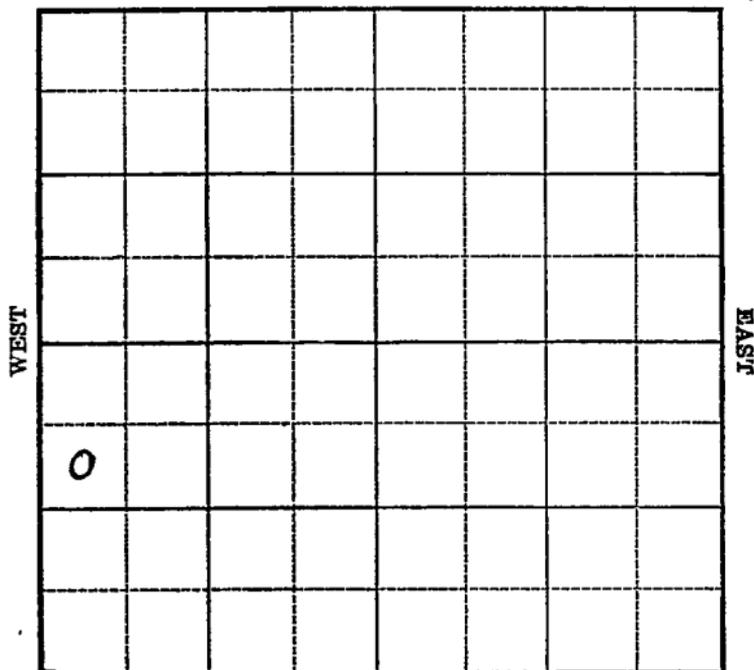

SOUTH



1939  
4/12

8" - 3029'

Lans. 2930'

T. D. 3049'

6000 acid.

Pressure bomb potential 6560 bbls.

Depthograph ~~XXX~~ Potential 7140

bbls.

Maximum potential allowed ?

**COMPLETED**

Map No. \_\_\_\_\_ Sec. 31 Twp. 17 R. 10W

Well No. 3 Patzner "B"

Spencer & Yarnell Company

Contractor

**FIRST REPORT**

SW NW SW

990 Ft. from N. Line

\_\_\_\_\_ Ft. from S. Line

\_\_\_\_\_ Ft. from E. Line

330 Ft. from W. Line

**SECTION PLAT**


**BLOOMER POOL**

Location \_\_\_\_\_

Rig up \_\_\_\_\_

Drilling and Remarks:

BCR

**RECORD**

Cased \_\_\_\_\_ in., \_\_\_\_\_ ft.

Sand \_\_\_\_\_

Gas \_\_\_\_\_

Oil \_\_\_\_\_

Total Depth \_\_\_\_\_

**PRODUCTION**

1st 24 hrs. Nat. \_\_\_\_\_

1st 24 hrs. after shot \_\_\_\_\_

Gas \_\_\_\_\_ Cu. Ft.

Dry Hole \_\_\_\_\_

Abandoned \_\_\_\_\_

Date

FEB 15 1939 19

H. D. Hatfield

Scout

