


Map No. _____ Sec. 7 Twp. 29 R. 4Well No. 7 Rutherford Farm
Ohio Company

NORTH

WEST

EAST

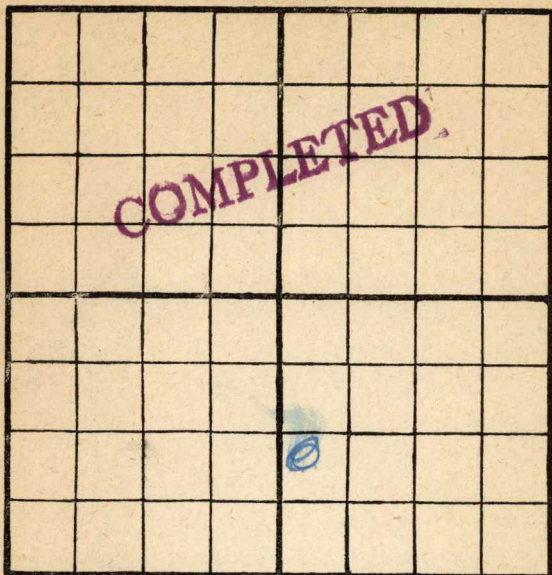

SOUTH

Location _____ Rig Up _____

Drilling Remarks:

35 1/2 lbs Sand 1825-1842)

Drilling Remarks:

6/5/18

RECORD

Cased _____ in. _____ ft.

Sand _____

Gas _____

Oil _____

Total Depth _____

PRODUCTION

1st 24 hrs. Nat. _____

1st 24 hrs. after shot _____

Gas _____ cu. ft


Dry Hole _____

Abandoned _____

Map No. 171 Sec. 7 Twp. 29 R. 4Well No. 7 Ruthersford FarmOhio Company

NORTH

WEST

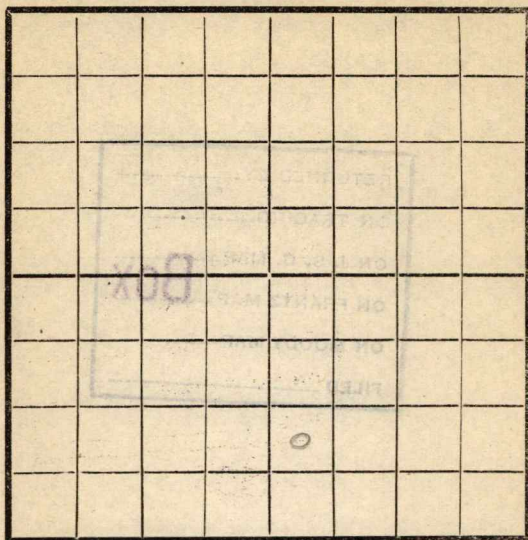

EAST

SOUTH

RECORD

Location -----

Cased ----- in. ----- Ft.

Rig Up -----

Sand -----

Drilling and remarks

Gas -----

Oil -----

Total Depth -----

PRODUCTION

1st 24 hrs. Nat. -----

1st 24 hrs. after shot -----

Gas ----- Cu. Ft.

Dry Hole -----

Abandoned -----

FIRST REPORT


Date

4/17, 1918 C. C. C. C. Scout

Map No. _____ Sec. 7 Twp. 29 R. 4
 Well No. 7 Butler Farm
Ohio Company

NORTH

WEST

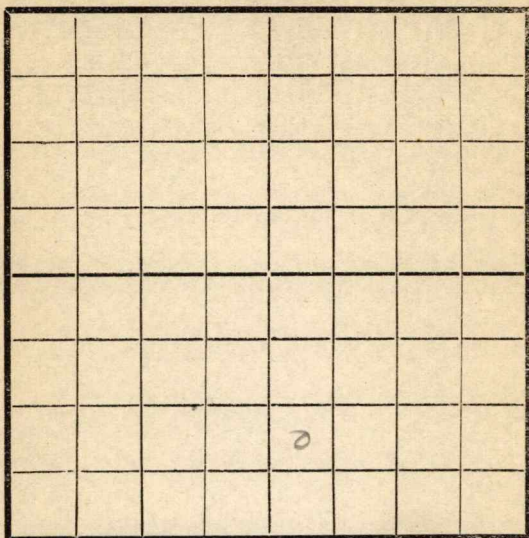

EAST

SOUTH

Location _____
 Rig Up _____
 Drilling and remarks

400

RECORD

Cased _____ in. _____ Ft.
 Sand _____
 Gas _____
 Oil _____
 Total Depth _____

PRODUCTION

1st 24 hrs. Nat. _____
 1st 24 hrs. after shot _____
 Gas _____ Cu. Ft.
 Dry Hole _____
 Abandoned _____


Date

4/24, 1918 C. C. Cady Scout

Map No. _____ Sec. 7 Twp. 29 R. 4Well No. 7 Panther Farm _____
Quip Company

NORTH

WEST

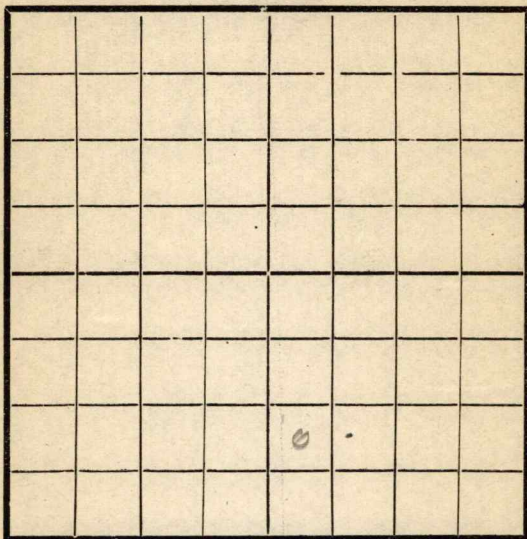

EAST

SOUTH

Location _____

Rig Up _____

Drilling and remarks

700Compassing Data

RECORD

Cased _____ in. _____ Ft.

Sand _____

Gas _____

Oil _____

Total Depth _____

PRODUCTION

1st 24 hrs. Nat. _____

1st 24 hrs. after shot _____

Gas _____ Cu. Ft.

Dry Hole _____

Abandoned _____

Date

37

, 191

8 Cuddy

Scout


Map No. _____ Sec. 7 Twp. 29 R. 4

Well No. 7 Ruthers Farm

Oliver Company

NORTH

WEST

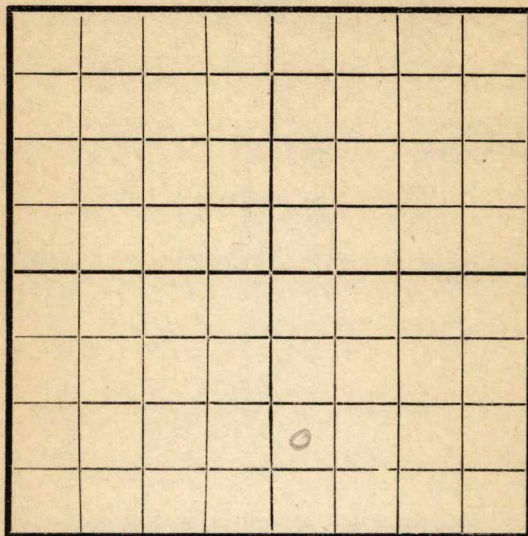

EAST

SOUTH

Location _____

Rig Up _____

Drilling and remarks

1150

RECORD

Cased _____ in. _____ Ft.

Sand _____

Gas _____

Oil _____

Total Depth _____

PRODUCTION

1st 24 hrs. Nat. _____

1st 24 hrs. after shot _____

Gas _____ Cu. Ft.

Dry Hole _____

Abandoned _____


Date

5/8, 1918 P. C. Cady Scout

Map No. _____ Sec. 7 Twp. 29 R. 4Well No. 7 Ruthersford Farm_____ Ohio Company

NORTH

WEST

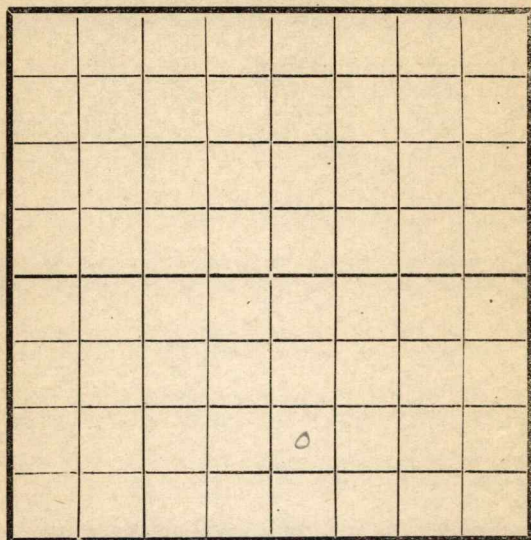

EAST

SOUTH

Location _____

Rig Up _____

Drilling and remarks

1450

RECORD

Cased _____ in. _____ Ft.

Sand _____

Gas _____

Oil _____

Total Depth _____

PRODUCTION

1st 24 hrs. Nat. _____

1st 24 hrs. after shot _____

Gas _____ Cu. Ft.

Dry Hole _____

Abandoned _____

Date

5/15, 1918 Candoy Scout

Form 26—1M Books of 100 Sheets Each.

Map No. _____ Sec. 7 Twp. 29 R. 4


Well No. 7 Ruthersford Farm

Ohio Company

NORTH

WEST

EAST

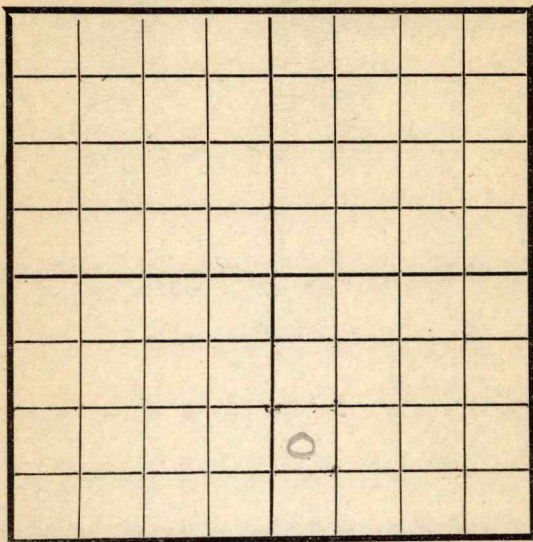

SOUTH

Location _____

Rig Up _____

Drilling and remarks

1725

RECORD

Cased _____ in _____ Ft.

Sand _____

Gas _____

Oil _____

Total Depth _____

PRODUCTION

1st 24 hrs. Nat. _____

1st 24 hrs. after shot _____

Gas _____ Cu. Ft.

Dry Hole _____

Abandoned _____

Date


5/22, 1918 Candy Scout

Map No. _____ Sec. 7 Twp. 29 R. 4
 Well No. 7 Ruthenburg Farm
Olin Company

NORTH

WEST

EAST

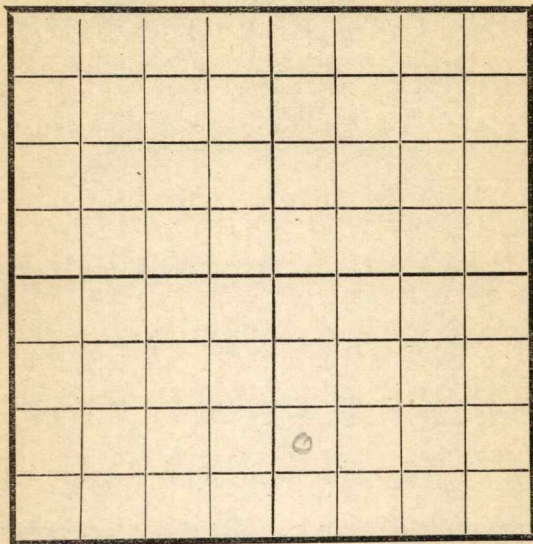

SOUTH

Location _____

Rig Up _____

Drilling and remarks

Dip sand 1825

RECORD

Cased _____ in. _____ Ft.

Sand _____

Gas _____

Oil _____

Total Depth _____

PRODUCTION

1st 24 hrs. Nat. _____

1st 24 hrs. after shot _____

Gas _____ Cu. Ft.

Dry Hole _____

Abandoned _____

Date

5/29, 191*8* *S. Conley* Scout

Map No. K11 Sec. 7 Twp. 29 R. 4Well No. 7 RuthersfordCompany OliverContractor Company Tools

NORTH

WEST

EAST

COMPLETED

SOUTH

Location _____

Rig up _____

Drilling and Remarks:

Est at
35 Bbls

RECORD

Cased _____ in., _____ ft.

Sand 1825-1842

Gas _____

Oil _____

Total Depth _____

PRODUCTION

1st 24 hrs. Nat. _____

1st 24 hrs. after shot _____

Gas _____ Cu. Ft.

Dry Hole _____

Abandoned _____

Date

6/5 191 S. Condy Scout