


Section.....31.....Township.....17.....Range.....10-W

Well Number.....3 Grizzell.....


Company.....Gulf.....

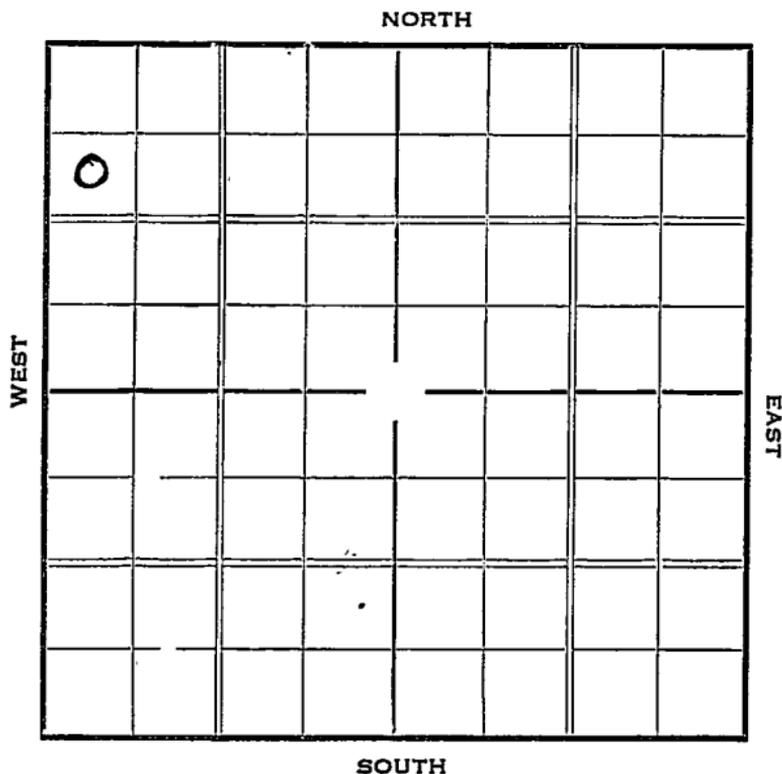

Sec. 31 Twp. 17 R. 10W

Well No. #3 Grizzell Farm
Gulf Company

990 Ft. from N. Line
 _____ Ft. from S. Line
 _____ Ft. from E. Line
330 Ft. from W. Line
 Elev. 1820

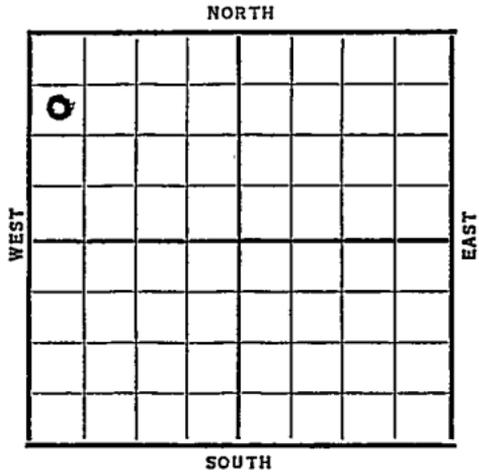

Date	REPORT
1937	
3/17	R O G
3/25	Rig.
4/2	Drlg. 1975'
4/8	Drlg. 3110'
4/16	Sil. 3261'. T. D. 3267'. Swabb 215 bbls. 6 hrs.
4/21	Sil. 3261'. T. D. 3270'.
	2000 acid.
	Potential 1848.
	COMPLETED

KANSAS *Ellsworth*

Map No. 555 Sec. 31 Twp. 17 R. 10W

Well No. 3 Griggell

Gulf Company

Contractor

SECTION PLAT

0			

990 Ft. from N. Line

_____ Ft. from S. Line

_____ Ft. from E. Line

330 Ft. from W. Line

FIRST REPORT

Location _____

Rig up _____

Drilling and Remarks:

ROG

RECORD

Cased _____ in., _____ ft.

Sand _____

Gas _____

Oil _____

Total Depth _____

PRODUCTION

1st 24 hrs. Nat. _____

1st 24 hrs. after shot _____

Gas _____ Cu. Ft.

Dry Hole _____

Abandoned _____

Date

MAR 17 1937

19

S. J. LEWIS

Scout

KANSAS *Ellsworth*

Map No. _____ Sec. *31* Twp. *17* R. *10W*

Well No. *3 Griggell*

Guy. D. Company

Contractor

SECTION PLAT

990 Ft. from N. Line

_____ Ft. from S. Line

_____ Ft. from E. Line

330 Ft. from W. Line

0			

COMPLETED

Location _____

Rig up _____

Drilling and Remarks:

Sic 3261
2000 acid
Potential
1848

RECORD

Cased _____ in., _____ ft.

Sand _____

Gas _____

Oil _____

Total Depth *3270*

PRODUCTION

1st 24 hrs. Nat. _____

1st 24 hrs. after shot _____

Gas _____ Cu. Ft.

Dry Hole _____

Abandoned _____

Date

APR 21 1937 19

S. J. LEWIS Scout