


Section 31 Township 17 Range 10-WWell No. #4 Gemeinhardt (B)Company Spencer & Yarnell

NORTH Bloomer Pool

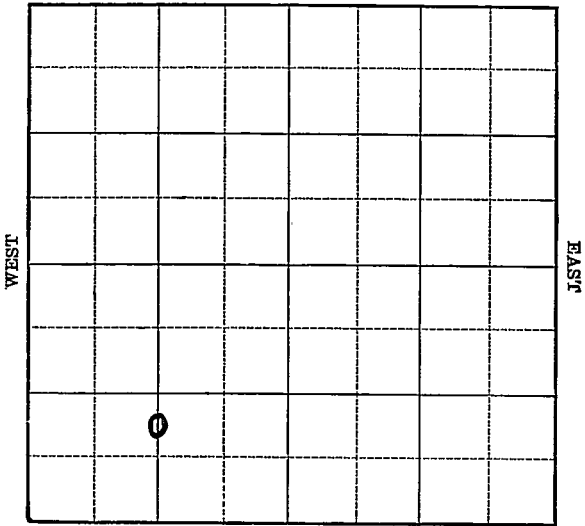

SOUTH

KANSAS


Ellsworth

Sec. 31 Twp. 17 R. 10-WWell No. #4 Gemeinhardt (P) FarmSpencer & Yarnell Company

(Bloomer)

 Ft. from N. Line990 Ft. from S. Line Ft. from E. Line1320 Ft. from W. Line

Elev. 1799

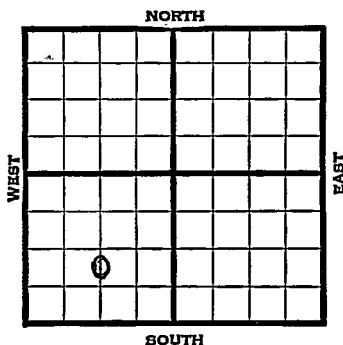

1939	REPORT
8/9	Cable.
8/17	Drlg. 246'
8/24	SD-2745' SD-2745'
8/31	" "
9/7	Never was as deep as 2745'
	15" - 130' Anhy 555'
	12" - 561' Drlg. 1435'
9/14	10" - 1916' T.D. 22000
	U. R. 10".
9/21	10" - 2230' Drlg. 2735'
9/28	Lans. 2940' S.O. 2940-50'
	S.G. 2960-70' S.O. 3025-31' TD
	8" - 3029' WOC.
10/5	Arb. 3229' T.D. 3234'
	6" - 3229' WOC.
10/12	Pump 102 bbls. oil 8 hours.
10/19	" " " " "
	OVER

1939

10/25 Arb. 3229'

6" - 3229'

T.D. 3234'

1000 acid.

Echometer potential 7068 bbls.

Maximum 2500 bbls.

COMPLETED

Map No. _____ Sec. 31 Twp. 17 R. 10WWell No. 4 Gemeinhardt (8)Spencer & Yarnell Company

Contractor

FIRST REPORTC N $\frac{1}{2}$ S $\frac{1}{2}$ SW

_____ Ft. from N. Line

990 Ft. from S. Line

_____ Ft. from E. Line

1320 Ft. from W. Line**BLOOMER POOL****SECTION PLAT**

Location _____

Rig up _____

Drilling and Remarks:

Cable**RECORD**

Cased _____ in., _____ ft.

Sand _____

Gas _____

Oil _____

Total Depth _____

PRODUCTION

1st 24 hrs. Nat. _____

1st 24 hrs. after shot _____

Gas _____ Cu. Ft.

Dry Hole _____

Abandoned _____

Date

AUG 9 1939 19S. J. LEWIS Scout


Map No. 55 Sec. 31 Twp. 17 R. 10WWell No. 4 Gemeinhardt (B)Spencer & Yarnell Company

Contractor

COMPLETED

C $N\frac{1}{2}$ $S\frac{1}{2}$ SW

SECTION PLAT

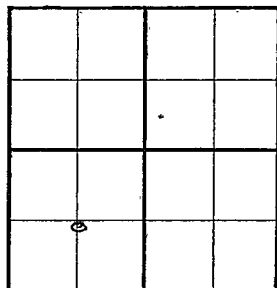

Ft. from N. Line

990 Ft. from S. Line

Ft. from E. Line

1320 Ft. from W. Line

BLOOMER POOL

Location _____

Rig up _____

Drilling and Remarks:

*Ar 83229**6" @ 3229**1000 acid**Echometer P & Y**7068**Maximum 2500*

RECORD

Cased _____ in., _____ ft.

Sand _____

Gas _____

Oil _____

Total Depth 3234

PRODUCTION

1st 24 hrs. Nat. _____

1st 24 hrs. after shot. _____

Gas _____ Cu. Ft.

Dry Hole _____

Abandoned _____

Date

OCT 25 1939

19

S. J. LEWIS

Scout