

O. W. D. D.

FORM 51 5M 1-42 PETROL


KANSAS

Greenwood

Section 15 Township 28 Range 8E

Well No. 3 #7 Youngmeyer + Palmer

Company K T Weidemann Beaumont Petr.

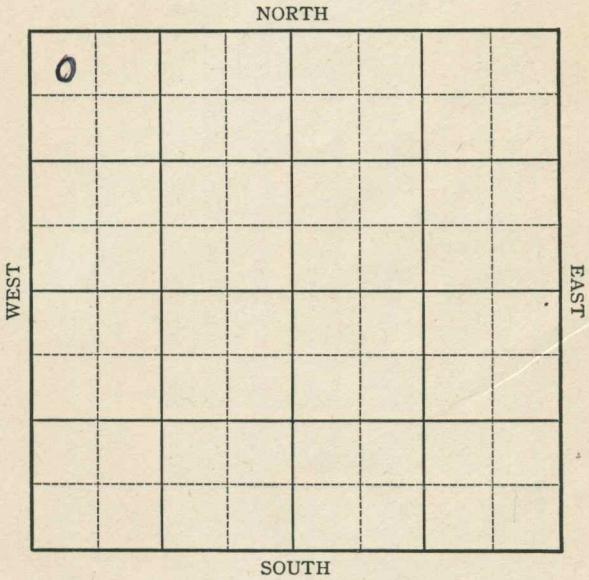

KANSAS

W D. D.

Greenwood

Sec. 15 Twp. 28 R. 8E

Well No. ³~~#1~~ Youngmeyer - Palmer Farm
~~H T Weidemann~~ Beaumont Petr. Company


Miscellaneous

330 Ft. from N. Line

Ft. from S. Line

Ft. from E. Line

330 Ft. from W. Line

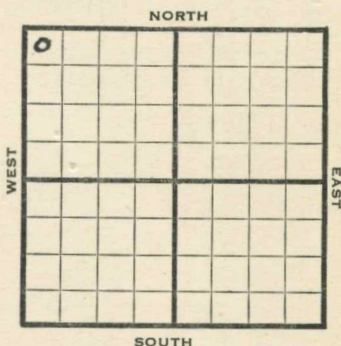

1944

REPORT

Date	Location
8/2	Location
8/9	"
8/16	"
8/23	Cellar
8/30	RUR
9/8	10" @ 17' Drlg. 1610
9/13	Drlg. 2418
9/21	Miss 2705
	5" @ 2705 RUST
9/28	" " " "
10/4	" " " "
10/11	Drlg. 2730 SO
10/18	TD 2736 300 acid
10/25	" " " " " "
11/1	" " " " "
11/8	" " " " "
11/16	" " " " "
11/24	" " " " "
11/29	" " " " " "
12/6	" " " " "
2/14	" " " " "
12/21	TD 2755 SD. Testing
12/29	" " " "

OVER

1945

1-3 Miss 2795
Total Depth 2755
5" @ 2705
Acid 500 gallons.
Pump 8 bbls. Potential
Gravity 36.

COMPLETED

1956

O. W. D. D.


8-1 Old info - OTD 2755; oil well
NEW INFO - TD 2795';
5" @ 2795
M. 2705';

KANSAS

Pool Name MiscellaneousMap No. 10 Sec. 15 Twp. 28 R. 8EWell No. 1 YoungmeirK. T. Weidemann CompanyFIRST REPORT Contractor

NW/C

SECTION PLAT

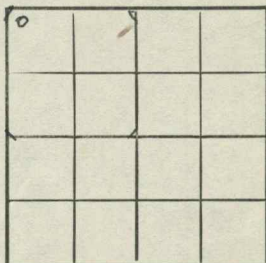330 Ft. from N. Line Ft. from S. Line Ft. from E. Line330 Ft. from W. LineGreenwood CountyLocation XRig up

Drilling and Remarks:

RECORD

Cased in., ft.Sand Gas Oil Total Depth

PRODUCTION

1st 24 hrs. Nat. 1st 24 hrs. after shot Gas Cu. Ft.Dry Hole Abandoned

Date

AUG 2 1944 19 S. J. LEWIS Scout

Pool Name MiscellaneousMap No. 1D Sec. 15 Twp. 28 R. 8EWell No. 1 YoungmeirK. T. Weidemann CompanyCOMPLETED Contractor

NW/C

SECTION PLAT

330 Ft. from N. Line Ft. from S. Line Ft. from E. Line330 Ft. from W. Line

Greenwood

0			

Location Rig up

Drilling and Remarks:

*Miss 2705**5" @ 2705**500 aciol**Pump 5 BX**36" La*

RECORD

Cased in., ft.Sand Gas Oil Total Depth 2755

PRODUCTION

1st 24 hrs. Nat. 1st 24 hrs. after shot Gas Cu. Ft.Dry Hole Abandoned

Date

JAN 3 1945 19S. J. LEWIS Scout