

KANSAS


Ellsworth

Form 51-5M-7-39-Palace

Section 31 Township 17 Range 10-W

Well No. #5 Gereinhardt (B)

Company Yarnell & Spencer

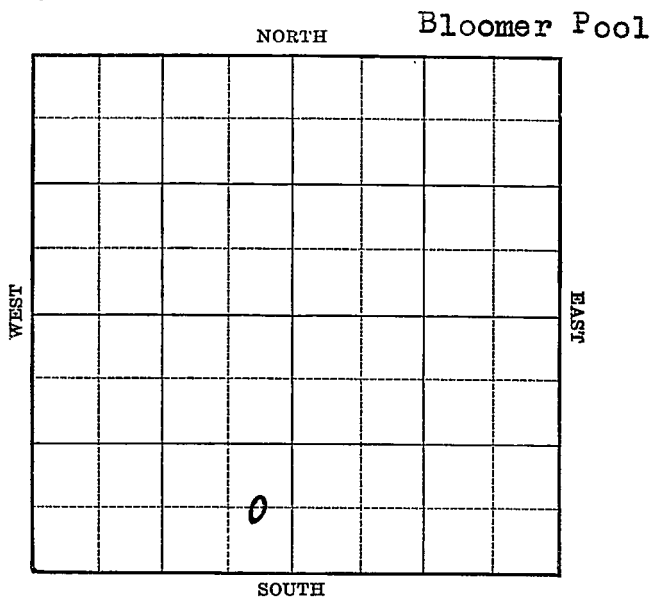


Sec. 31 Twp. 17 R. 10-WWell No. #5 Gemeinhardt (B) Farm
Yarnell & Spencer Company

(Bloomer)

 Ft. from N. Line660 Ft. from S. Line330 Ft. from E. Line Ft. from W. Line

Elev. 1794

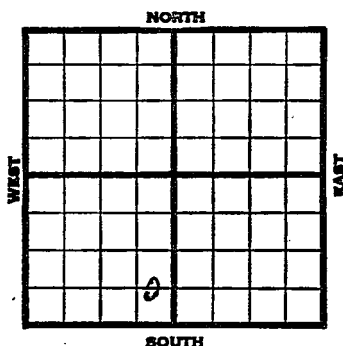

1940	REPORT
2/7	R.O.G.
2/15	Cable rig.
2/23	15" - 190' Drlg. 280'
2/29	Anhy 548' 12½" - 551'
	Drlg. 1560'
3/8	10" - 1910' 8" - 2280'
	Drlg. 2350'
3/14	Lans. 2940' SO & G. 2942'
	SO 3024' 7" - 3032'
	Drlg. 3050'
3/21	Arb. 3229' T.D. 3231'
	7" - 3230' WOC.
3/27	Arb. 3229'
	7" - 3230'
	T.D. 3231'
	Depthograph 13,000 bbls.
	Maximum 3000 bbls.
	COMPLETED

Map No. 55 Sec. 31 Twp. 17 R. 10WWell No. 5 Gemeinhardt (B)Yarnell & Spencer Company

Contractor

FIRST REPORT

C E L S E S W

 Ft. from N. Line660 Ft. from S. Line330 Ft. from E. Line Ft. from W. Line

BLOOMER POOL

SECTION PLAT

Location Rig up

Drilling and Remarks:

R.O.G.

RECORD

Cased in., ft.Sand Gas Oil Total Depth

PRODUCTION

1st 24 hrs. Nat. 1st 24 hrs. after shot Gas Cu. Ft.Dry Hole Abandoned

Date

FEB 7 1940 19

S. J. LEWIS

Scout

Ellsworth **KANSAS**Map No. 55 Sec. 31 Twp. 17 R. 10WWell No. 5 Gemeinhardt (B)Yarnell & Spencer

Company

Contractor

COMPLETED**C E L SE SW****SECTION PLAT**

 Ft. from N. Line660 Ft. from S. Line330 Ft. from E. Line Ft. from W. Line**BLOOMER POOL**Location Rig up

Drilling and Remarks:

*Ar 83229**7" C 3230**Depthograph 28
13000**Maximum 3000***RECORD**Cased in., ft.Sand Gas Oil Total Depth 3231**PRODUCTION**1st 24 hrs. Nat. 1st 24 hrs. after shot Gas Cu. Ft.Dry Hole Abandoned

Date

MAR 27 1940 19

S. J. LEWIS Scout