

KANSAS


Ellsworth

Form 51-5M-7-39-Palace

Section 31 Township 17 Range 10-W

Well No. #5 Moran

Company Skelly

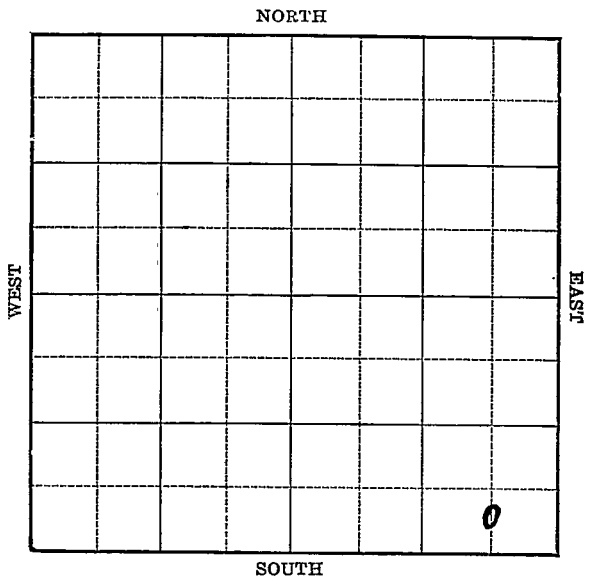

Ellsworth **KANSAS**

Map No. 53 Sec. 31 Twp. 17 R. 10W

Well No. 5 Moran

Skelly

Company

Contractor

C S L SE SE

SECTION PLAT

_____ Ft. from N. Line

330 Ft. from S. Line

660 Ft. from E. Line

_____ Ft. from W. Line

			e

BLOOMER POOL

Location X

RECORD

Rig up _____

Drilling and Remarks:

Cased _____ in., _____ ft.

Sand _____

Gas _____

Oil _____

Total Depth _____

PRODUCTION

1st 24 hrs. Nat. _____

1st 24 hrs. after shot _____

Gas _____ Cu. Ft.

Dry Hole _____

Abandoned _____

Date

JAN 24 1940 19

S. I. LEWIS

Scout

Map No. 55 Sec. 31 Twp. 17 R. 10W

Well No. 5 Moran

Skelly

Company

Contractor

COMPLETED

SECTION PLAT

C S L SE SE

 Ft. from N. Line

330 Ft. from S. Line

660 Ft. from E. Line

 Ft. from W. Line

BLOOMER POOL

			o

Location

Rig up

Drilling and Remarks:

*Cor 83224
5 1/2" @ 3225*

*Echome TELP
4643*

Maximum 3000

RECORD

Cased in., ft.

Sand

Gas

Oil

Total Depth 3225 1/2

PRODUCTION

1st 24 hrs. Nat.

1st 24 hrs. after shot

Gas Cu. Ft.

Dry Hole

Abandoned

Date

FEB 28 1941 19

S. J. LEWIS

Scout