


Section 7 Township 29 Range 4E

Well No. #1 Wakefield

Company Greeley Drlg.

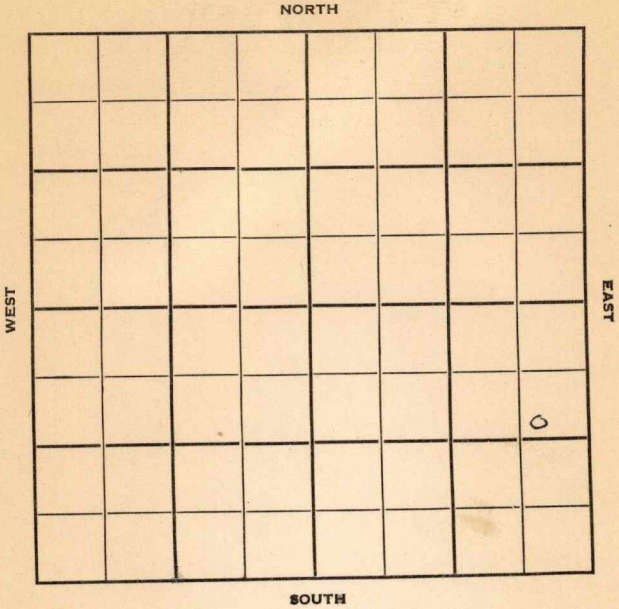

KANSAS

Butler

Sec. 7 Twp. 29 R. 4-E

Well No. #1 Wakefield Farm

Greeley Drlg. Company

Greeley Drlg. Contractor


Douglas
1270 Ft. from N. Line

_____ Ft. from S. Line

562 Ft. from E. Line

_____ Ft. from W. Line

SE NE SE

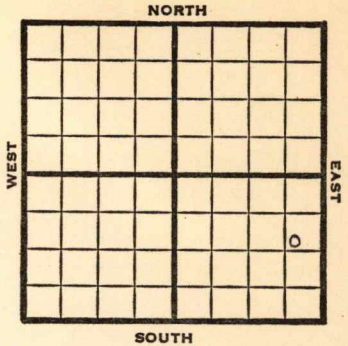

1950

Elev 1260

REPORT

10/4 RUR

10/18 Spud 10-4-50

8 5/8" @ 69

Arb 2943

TD 3100

D&A

ABANDONED

