

KANSAS

Form 51-5M-11-38-Palace


Ellsworth

Section 31 Township 17 Range 10-W

Well No. #4 Patzner (B)

Company Spencer & Yarnell

NORTH Bloomer Pool

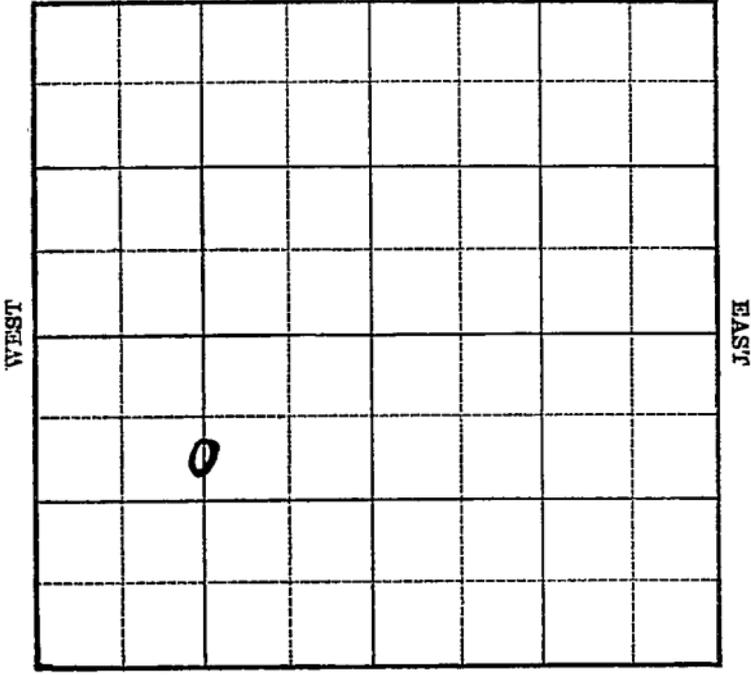

SOUTH

Sec. 31 Twp. 17 R. 10-W

Well No. #4 Patzner (B) Farm

Spencer & Yarnell Company


(Bloomer)

990 Ft. from N. Line

_____ Ft. from S. Line

_____ Ft. from E. Line

1320 Ft. from W. Line

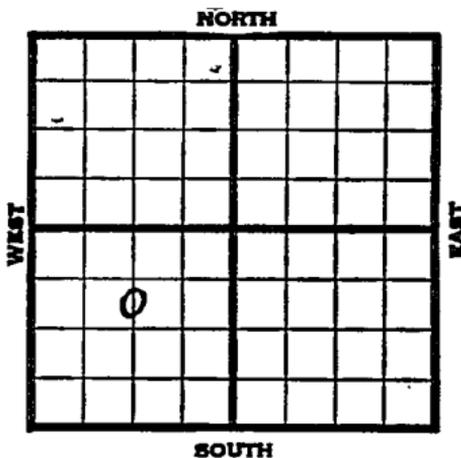

Elev. 1803

1939	REPORT
10/25	Cellar.
11/2	Rigging up cable.
11/9	" " "
11/16	15" - 90' 12" - 230'
	Fsg. 410'
11/23	Anhy 562' 12" - 570'
	Drlg. 1050'
11/29	1850' run 10".
12/7	10" - 1814' 8" - 2115'
	Drlg. 2390'
12/14	Lans. 2945' S.O. 3070-72'
	7" - 3074' Drlg. 3115'
12/21	Arb. 3267 ³²⁶⁹ ' 5" - 3268'
	T.D. 3275' 500' oil 5 hrs.
12/28	Arb. 3269' (Corrected)
	T.D. 3374½' 1500 acid.
	No test.
	OVER

1940

1/3

Arb. 3269'

5" - 3268'

T.D. 3275'

1500 acid.

Pump 33 barrels.

COMPLETED

Ellsworth **KANSAS**Map No. _____ Sec. **31** Twp. **17** R. **10W**Well No. **4 Patzner (B)****Spencer & Yarnell** Company

Contractor

FIRST REPOI**SECTION PLAT****C S L N $\frac{1}{2}$ SW**
990 Ft. from N. Line

_____ Ft. from S. Line

_____ Ft. from E. Line

1320 Ft. from W. Line

BLOOMER POOL

Location _____

Rig up _____

Drilling and Remarks:

Cellar**RECORD**

Cased _____ in., _____ ft.

Sand _____

Gas _____

Oil _____

Total Depth _____

PRODUCTION

1st 24 hrs. Nat. _____

1st 24 hrs. after shot _____

Gas _____ Cu. Ft.

Dry Hole _____

Abandoned _____

Date

OCT 25 1903 19**S. J. LEWIS** Scout

Map No. 55 Sec. 31 Twp. 17 R. 10W

Well No. 4 Patzner (B)

Spencer & Yarnell Company

Contractor

COMPLETED

C S L N $\frac{1}{2}$ SW

SECTION PLAT

990 Ft. from N. Line

_____ Ft. from S. Line

_____ Ft. from E. Line

1320 Ft. from W. Line

	⊙		

BLOOMER POOL

Location _____

RECORD

Cased _____ in., _____ ft.

Sand _____

Gas _____

Oil _____

Total Depth 3225

PRODUCTION

1st 24 hrs. Nat. _____

1st 24 hrs. after shot _____

Gas _____ Cu. Ft.

Dry Hole _____

Abandoned _____

Drilling and Remarks:

Core 3269

3" @ 3268

1500 acid

Pump 33 ft

Date

.0 19

S. J. LEWIS Scout