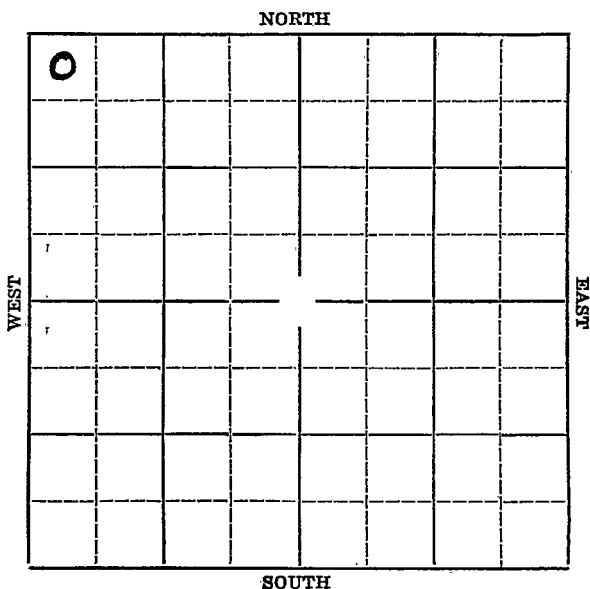


Section 31 Township 17 Range 10-WWell Number 5 GrizzellCompany Gulf

1937

6/9

6" @ 3272'.

Sil. 3272'.

T.D. 3289'.

2000 Acid @ 3281'.

4000 acid @ 3289'.

Pumped 310 bbls. 6 hrs.

Pot. 1116 bbls.

COMPLETED

KANSAS

Ellsworth

Map No. _____ Sec. 31 Twp. 17 R. 10WWell No. 5 GriggellGuly D Company

Contractor

SECTION PLAT

0			

330 Ft. from N. Line

_____ Ft. from S. Line

_____ Ft. from E. Line

330 Ft. from W. Line

FIRST REPORT

Location _____

Rig up _____

Drilling and Remarks:

Rig

RECORD

Cased _____ in., _____ ft.

Sand _____

Gas _____

Oil _____

Total Depth _____

PRODUCTION

1st 24 hrs. Nat. _____

1st 24 hrs. after shot _____

Gas _____ Cu. Ft.

Dry Hole _____

Abandoned _____

Date

APR 21 1937 19

S. J. LEWIS Scout

Map No. 55 Sec. 31 Twp. 17 R. 10^WWell No. 5-GrizzellGulf Company

Contractor

COMPLETED

330 Ft. from N. Line

_____ Ft. from S. Line

_____ Ft. from E. Line

330 Ft. from W. Line

SECTION PLAT

0			

Location _____

Rig up _____

Drilling and Remarks:

2000 Acid @ 32894000 Acid @ 3289Pumped 310/6 hrsPat - 1116

RECORD

Cased 6 in., 3272 ft.Sand S11 3272

Gas _____

Oil _____

Total Depth 3289

PRODUCTION

1st 24 hrs. Nat. _____

1st 24 hrs. after shot _____

Gas _____ Cu. Ft.

Dry Hole _____

Abandoned _____

Date

JUN 9 1937 19 H. D. Hatfield Scout