

# KANSAS

FORM 51 5M 4-41 PETROL


Ellsworth

Section 31 Township 17 Range 10-W

Well No. #5 Patzner (A)

Company Spencer & Yarnell

NORTH Bloomer Pool

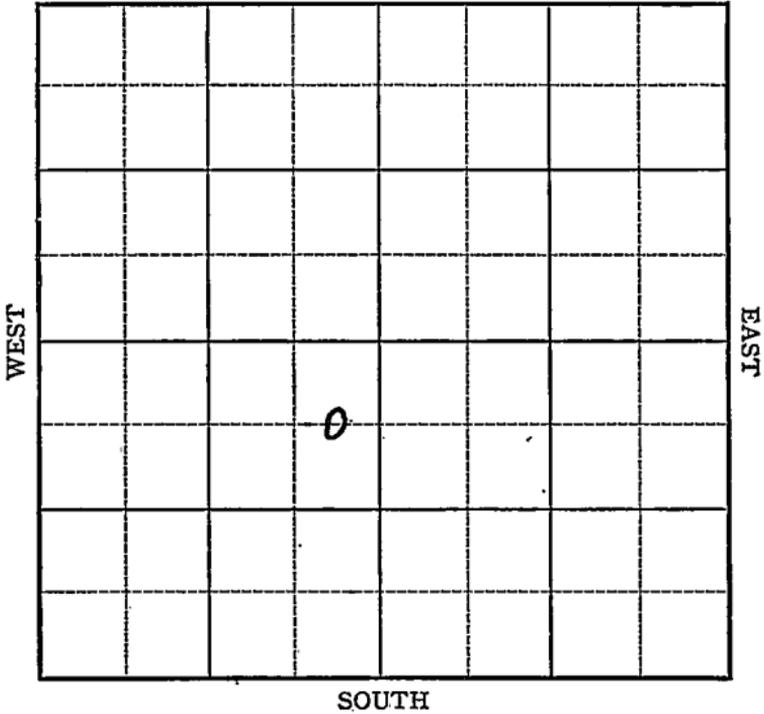

SOUTH



1941

7/23

Arb. 3278'

7" - 3283'

T.D. 3298'

Potential 183 bbls., pump.

**COMPLETED**

Map No. 55 Sec. 31 Twp. 17 R. 10W

Well No. 5 Patzner (B)

Spencer & Yarnell Company

**FIRST REPORT** Contractor

**SECTION PLAT**

**C E L N E S W**

660 Ft. from N. Line

\_\_\_\_\_ Ft. from S. Line

330 Ft. from E. Line

\_\_\_\_\_ Ft. from W. Line

	o		

**BLOOMER POOL**

Location X

Rig up \_\_\_\_\_

Drilling and Remarks:

**RECORD**

Cased \_\_\_\_\_ in., \_\_\_\_\_ ft.

Sand \_\_\_\_\_

Gas \_\_\_\_\_

Oil \_\_\_\_\_

Total Depth \_\_\_\_\_

**PRODUCTION**

1st 24 hrs. Nat. \_\_\_\_\_

1st 24 hrs. after shot \_\_\_\_\_

Gas \_\_\_\_\_ Cu. Ft.

Dry Hole \_\_\_\_\_

Abandoned \_\_\_\_\_

Date

MAY 14 1941 19 \_\_\_\_\_ S. J. LEWIS Scout

Map No. \_\_\_\_\_ Sec. 31 Twp. 17 R. 10W

Well No. 5 Patzner (B)

Spencer & Yarnell Company

Contractor

**COMPLETED**

**SECTION PLAT**

660 **C E L NESW**  
Ft. from N. Line

\_\_\_\_\_ Ft. from S. Line

330 Ft. from E. Line

\_\_\_\_\_ Ft. from W. Line


**BLOOMER POOL**

**RECORD**

Location \_\_\_\_\_

Cased \_\_\_\_\_ in., \_\_\_\_\_ ft.

Rig up \_\_\_\_\_

Sand \_\_\_\_\_

Drilling and Remarks:

Gas \_\_\_\_\_

Oil \_\_\_\_\_

Total Depth 3298

*Cor 73275.  
> " @ 3283  
Pump 183 ft.*

**PRODUCTION**

1st 24 hrs. Nat. \_\_\_\_\_

1st 24 hrs. after shot \_\_\_\_\_

Gas \_\_\_\_\_ Cu. Ft.

Dry Hole \_\_\_\_\_

Abandoned \_\_\_\_\_

Date

III 23 1941 19

S. J. LEWIS

Scout