


Map No. _____ Sec. 8 Twp. 29 E. 4Well No. 6 Rutherford FarmOhio Company

NORTH

WEST

EAST

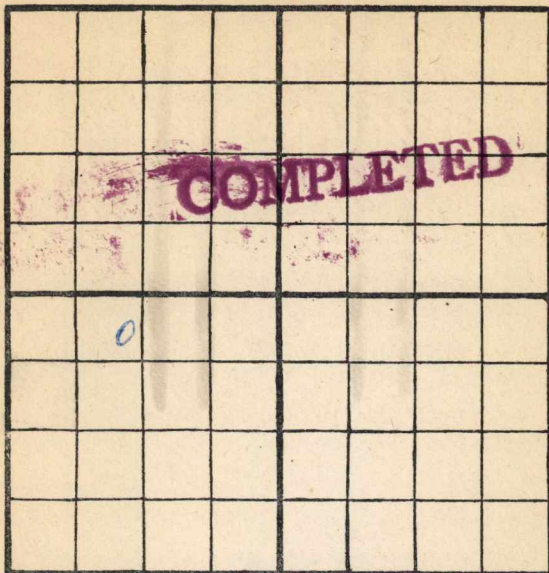

SOUTH

Location _____

Rig Up _____

Drilling Remarks:

Drilling Remarks:

RECORD

Cased _____ in. _____ ft.

Sand _____

Gas _____

Oil _____

Total Depth _____

PRODUCTION

1st 24 hrs. Nat. _____

1st 24 h.s. after shot _____

Gas _____ cu. ft


Dry Hole _____

Abandoned _____

Map No. _____ Sec. 8 Twp. 29 R. 4
 Well No. 6 Rutherford Farm _____
Ohio Company _____

NORTH

WEST

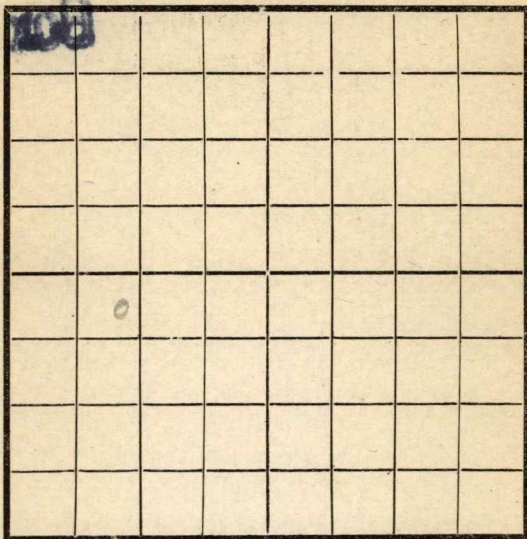

EAST

SOUTH

Location _____
 Rig Up ☒ _____
 Drilling and remarks _____

FIRST REPORT

RECORD

Cased _____ in. _____ Ft.
 Sand _____
 Gas _____
 Oil _____
 Total Depth _____

PRODUCTION

1st 24 hrs. Nat. _____
 1st 24 hrs. after shot _____
 Gas _____ Cu. Ft.
 Dry Hole _____
 Abandoned _____


Date

11/28, 1912 C. D. Jeff Scout

Map No. _____ Sec. 8 Twp. 29 R. 4Well No. 6 Parthenon FarmOhio Company

NORTH

WEST

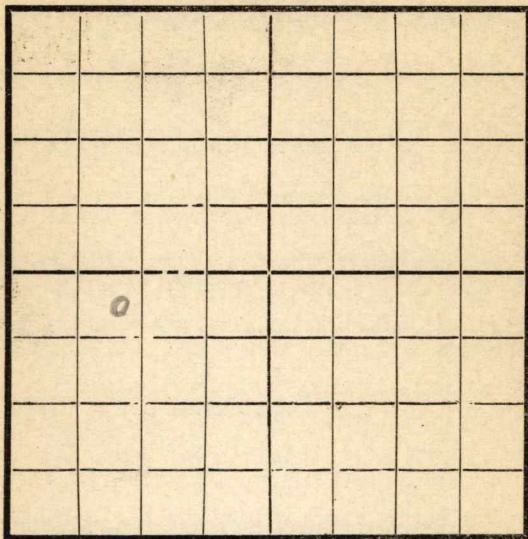

EAST

SOUTH

Location _____

Rig Up _____

Drilling and remarks _____

RECORD

Cased _____ in. _____ Ft.

Sand _____

Gas _____

Oil _____

Total Depth _____

PRODUCTION

1st 24 hrs. Nat. _____

1st 24 hrs. after shot _____

Gas _____ Cu. Ft.

Dry Hole _____

Abandoned _____


Date

12/5, 1917 Condeff Scout

Map No. _____ Sec. 8 Twp. 29 R. 4
 Well No. 6 Ruthers Farm _____
Oliver Company _____

NORTH

WEST

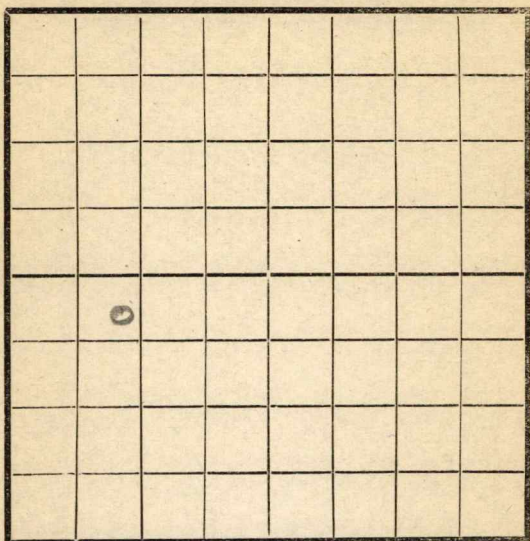

EAST

SOUTH

RECORD

Location _____
 Rig Up _____
 Drilling and remarks

Cased _____ in. _____ Ft.
 Sand _____
 Gas _____
 Oil _____
 Total Depth _____

PRODUCTION

1st 24 hrs. Nat. _____
 1st 24 hrs. after shot _____
 Gas _____ Cu. Ft.
 Dry Hole _____
 Abandoned _____

Rigging


Date

12/12, 1917 Condy Scout

Map No. _____ Sec. 8 Twp. 29 R. 4Well No. 6 Ruthenburg Farm_____
Company

NORTH

WEST

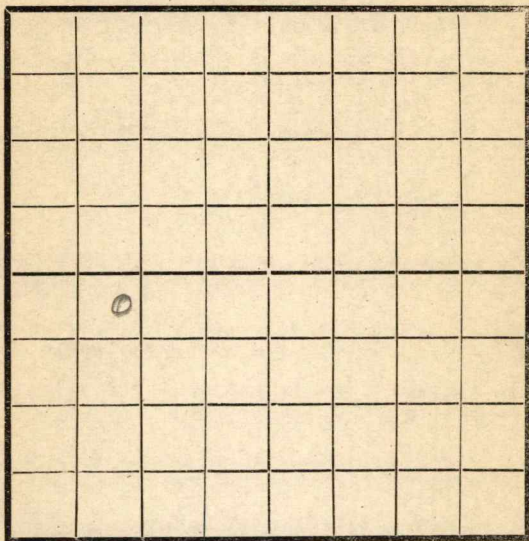

EAST

SOUTH

Location _____

Rig Up _____

Drilling and remarks

150

RECORD

Cased _____ in. _____ Ft.

Sand _____

Gas _____

Oil _____

Total Depth _____

PRODUCTION

1st 24 hrs. Nat. _____

1st 24 hrs. after shot _____

Gas _____ Cu. Ft.

Dry Hole _____

Abandoned _____

Date


12/19, 1917 Candoff Scout

Map No. _____ Sec. 8 Twp. 29 R. 4Well No. 6 Ruthersford FarmOhio

Company _____

NORTH

WEST

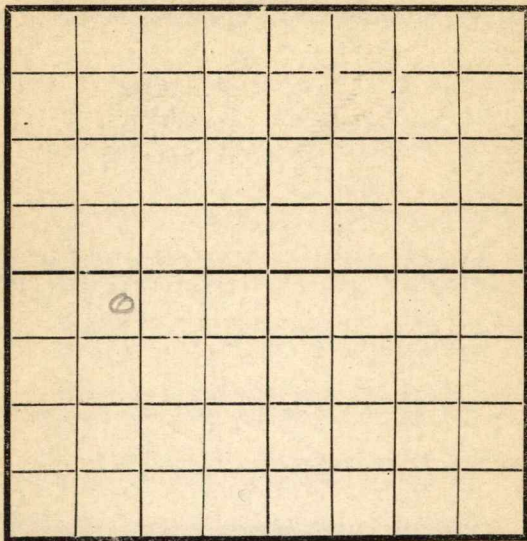

EAST

SOUTH

Location _____

Rig Up _____

Drilling and remarks

640

RECORD

Cased _____ in. _____ Ft.

Sand _____

Gas _____

Oil _____

Total Depth _____

PRODUCTION

1st 24 hrs. Nat. _____

1st 24 hrs. after shot _____

Gas _____ Cu. Ft.

Dry Hole _____

Abandoned _____


Date

12/28, 1917 Condy Scout

Map No. _____ Sec. 8 Twp. 29 R. 4Well No. 6 Ruthenford Farm _____
Ohio Company _____

NORTH

WEST

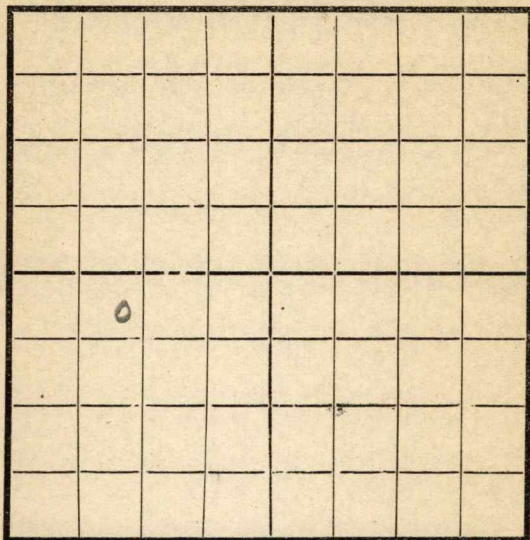

EAST

SOUTH

Location _____

Rig Up _____

Drilling and remarks

880

RECORD

Cased _____ in. _____ Ft.

Sand _____

Gas _____

Oil _____

Total Depth _____

PRODUCTION

1st 24 hrs. Nat. _____

1st 24 hrs. after shot _____

Gas _____ Cu. Ft.

Dry Hole _____

Abandoned _____

Date

1/2, 1918 C. Cardiff Scout


Map No. _____ Sec. 8 Twp. 29 R. 4

Well No. 6 Rutherford Farm

Company _____

NORTH

WEST

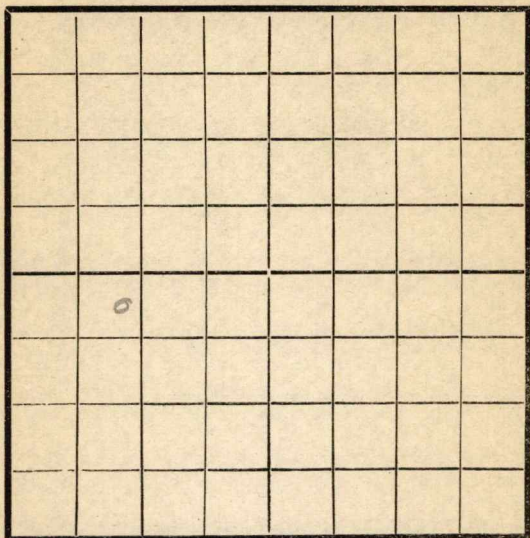

EAST

SOUTH

RECORD

Location _____

Cased _____ in. _____ Ft.

Rig Up _____

Sand _____

Drilling and remarks

Gas _____

Oil _____

Total Depth _____

1350

PRODUCTION

1st 24 hrs. Nat. _____

1st 24 hrs. after shot _____

Gas _____ Cu. Ft.

Dry Hole _____

Abandoned _____


Date

1/9, 1918 J. Condyff Scout

Map No. _____ Sec. 8 Twp. 29 R. 4
 Well No. 6 Rutherglen Farm _____
Olin Company _____

NORTH

WEST

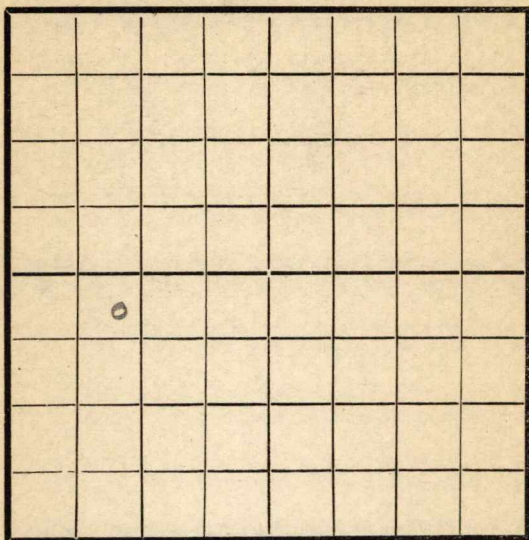

EAST

SOUTH

Location _____

Rig Up _____

Drilling and remarks

1300

RECORD

Cased _____ in. _____ Ft.

Sand _____

Gas _____

Oil _____

Total Depth _____

PRODUCTION

1st 24 hrs. Nat. _____

1st 24 hrs. after shot _____

Gas _____ Cu. Ft.

Dry Hole _____

Abandoned _____


Date

1/16, 1918 C. C. C. Scout

Map No. _____ Sec. 8 Twp. 29 R. 4
 Well No. 6 Ruthersford Farm
Ohio Company

NORTH

WEST

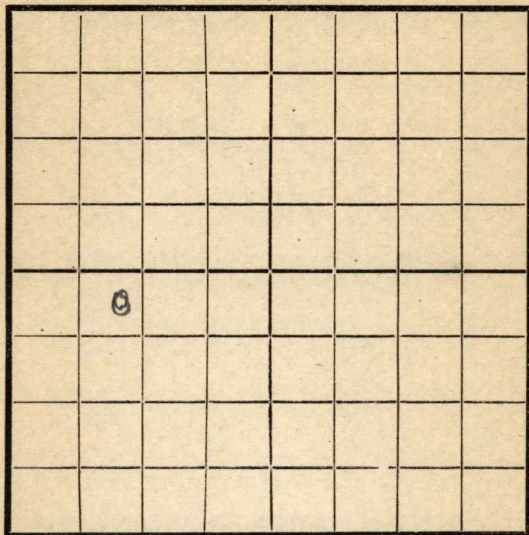

EAST

SOUTH

Location _____

Rig Up _____

Drilling and remarks

Collapsed
Casing
1430'

RECORD

Cased _____ in. _____ Ft.
 Sand _____
 Gas _____
 Oil _____
 Total Depth _____

PRODUCTION

1st 24 hrs. Nat. _____
 1st 24 hrs. after shot _____
 Gas _____ Cu. Ft.
 Dry Hole _____
 Abandoned _____


Date

1/23, 1918 8 Carley Scout

Map No. _____ Sec. 8 Twp 29 R. 4
 Well No. 6 Pantherford Farm _____
Ohio Company _____

NORTH

WEST

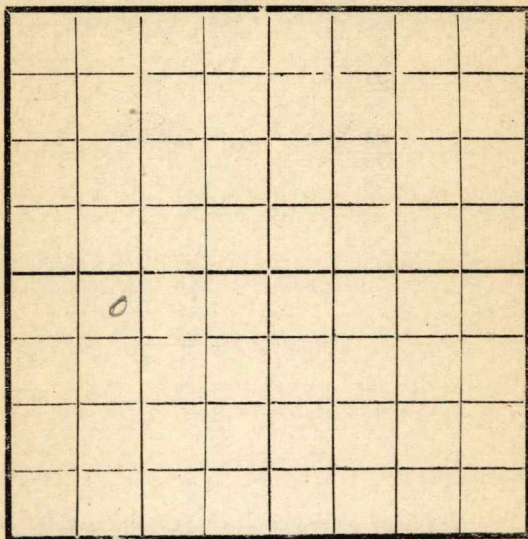

EAST

SOUTH

RECORD

Location _____

Cased _____ in. _____ Ft.

Rig Up _____

Sand _____

Drilling and remarks

Gas _____

Oil _____

Total Depth _____

PRODUCTION

1st 24 hrs. Nat. _____

1st 24 hrs. after shot _____

Gas _____ Cu. Ft.

Dry Hole _____

Abandoned _____


Date

1/30, 1918 Card Scout

Map No. _____ Sec. 8 Twp. 29 R. 4
 Well No. 6 Ruthersford Farm
Ohio Company

NORTH

WEST

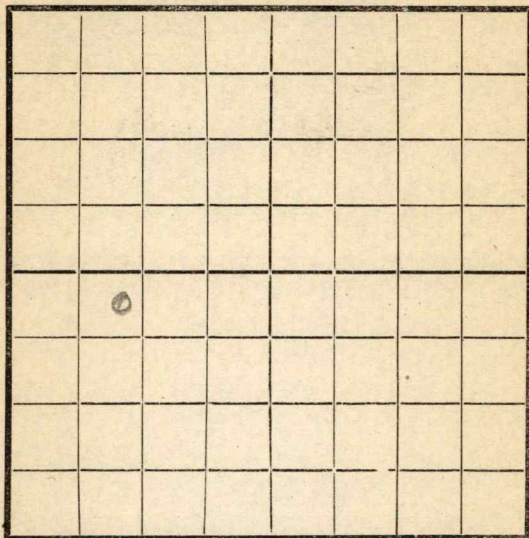

EAST

SOUTH

Location _____

Rig Up _____

Drilling and remarks

RECORD

Cased _____ in. _____ Ft.

Sand _____

Gas _____

Oil _____

Total Depth _____

PRODUCTION

1st 24 hrs. Nat. _____

1st 24 hrs. after shot _____

Gas _____ Cu. Ft.

Dry Hole _____

Abandoned _____


Date

2/13, 1918 Conroy Scout

Map No. _____ Sec. 8 Twp. 29 R. 4Well No. 6 Rutledge Farm_____
Company

NORTH

WEST

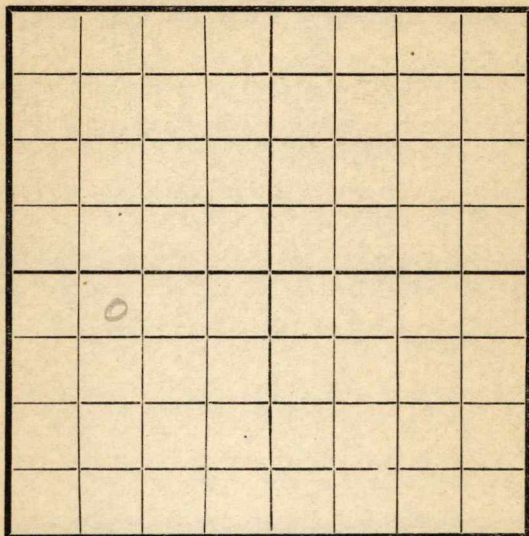

EAST

SOUTH

Location _____

Rig Up _____

Drilling and remarks

1650

RECORD

Cased _____ in. _____ Ft.

Sand _____

Gas _____

Oil _____

Total Depth _____

PRODUCTION

1st 24 hrs. Nat. _____

1st 24 hrs. after shot _____

Gas _____ Cu. Ft.

Dry Hole _____

Abandoned _____


Date

7/30, 1918 C. C. Cady Scout

Map No. _____ Sec. 8 Twp. 29 R. 4
 Well No. 6 Ruthersford Farm _____
Ohio Company _____

NORTH

WEST

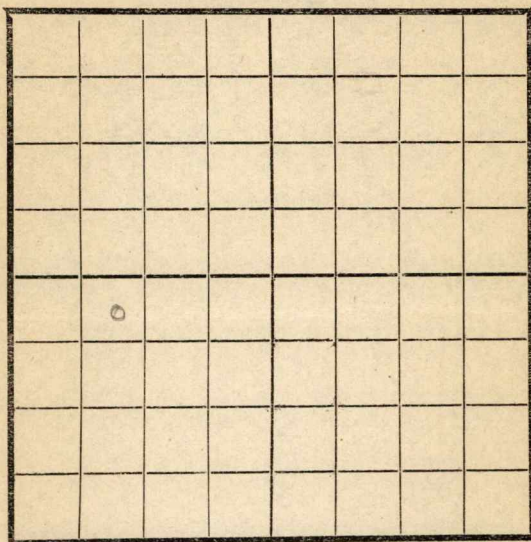

EAST

SOUTH

RECORD

Location _____

Cased _____ in. _____ Ft.

Rig Up _____

Sand _____

Drilling and remarks

Gas _____

Oil _____

Total Depth _____

1870

PRODUCTION

1st 24 hrs. Nat. _____

1st 24 hrs. after shot _____

Gas _____ Cu. Ft.

Dry Hole _____

Abandoned _____

Date

2/27, 1918 C. C. C. C. Scout

Map No. _____ Sec. 8 Twp. 39 R. 4


Well No. 6 Rutledge Farm

Olin Company

NORTH

WEST

EAST

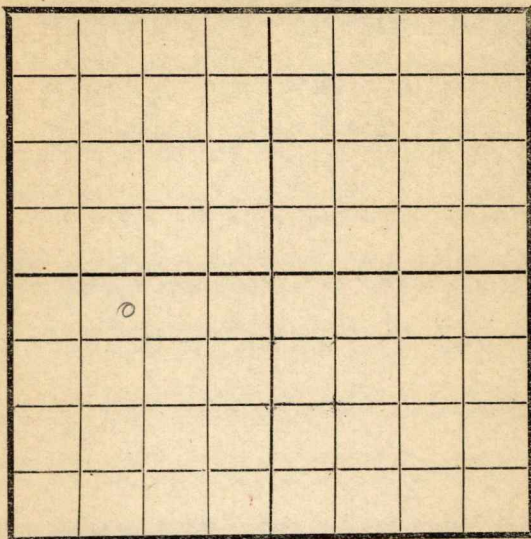

SOUTH

Location _____

Rig Up _____

Drilling and remarks

SD 1800

RECORD

Cased _____ in _____ Ft.

Sand _____

Gas _____

Oil _____

Total Depth _____

PRODUCTION

1st 24 hrs. Nat. _____

1st 24 hrs. after shot _____

Gas _____ Cu. Ft.

Dry Hole _____

Abandoned _____

Date


3/6, 1911 S. Conder

Scout

Map No. K11 Sec. 8 Twp. 29 R. 4Well No. 6 Rutherglen FarmOliver Company

NORTH

WEST

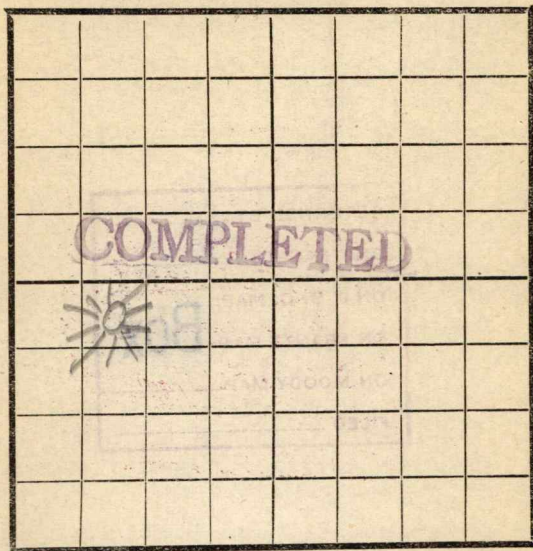

EAST

SOUTH

RECORD

Location -----

Cased ----- in ----- Ft.

Rig Up -----

Sand 1879-1888

Drilling and remarks

Gas -----

Est at

Oil -----

3500000

Total Depth -----

cu ft gas

PRODUCTION

1st 24 hrs. Nat. -----

1st 24 hrs. after shot -----

Gas ----- Cu. Ft.

Dry Hole -----

Abandoned -----

Date

5/16, 1918 J. Conroy Scout