


Section 31 Township 17 Range 10-W

Well Number 6 - Grizzell

Company Gulf

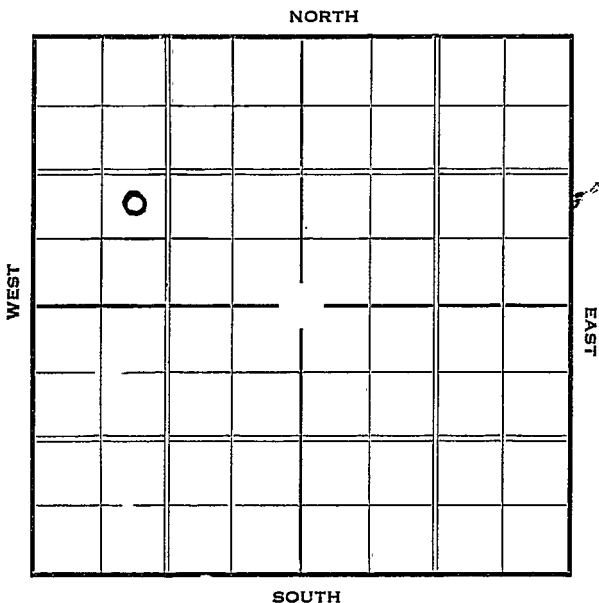

Sec. 31 Twp. 17 R. 10-W

Well No. #6 Grizzell Farm


Gulf Company

_____ Ft. from N. Line

990 Ft. from S. Line

_____ Ft. from E. Line

990 Ft. from W. Line

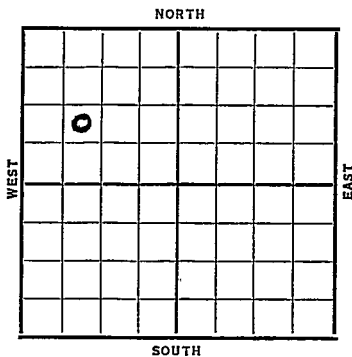

Special

Date	Elev. 1806	REPORT
1937		
5/12		B.R.R.
5/21		10" @ 188'. Drlg. 1790'.
5/28		K.C. 2945'. S.O. 3000' and at 3063-71'. Coring.
6/4		Sil. 3235-39' T.D. 7" @ 3235'.
6/11		T.D. 3245'. Pumped 1110 oil 12 hrs.
6/16		7" @ 3235'. Sil. 3235'. T.D. 3245'. 2000 A Pump 1111 bbls. 12 hrs. Pot. 2222 bbls. 24 hrs.
		COMPLETED

KANSAS

Ellsworth

Map No. 53 Sec. 31 Twp. 17 R. 10 W

Well No. 6-Grizzell

Gulf Company
Contractor

FIRST REPORT

SECTION PLAT

_____ Ft. from N. Line

1990 Ft. from S. Line

_____ Ft. from E. Line

990 Ft. from W. Line

Special

Special

0			

Location _____

Rig up _____

Drilling and Remarks:

B.R.R.

RECORD

Cased _____ in., _____ ft.

Sand _____

Gas _____

Oil _____

Total Depth _____

PRODUCTION

1st 24 hrs. Nat. _____

1st 24 hrs. after shot _____

Gas _____ Cu. Ft.

Dry Hole _____

Abandoned _____

Date

MAY 12 1937 19

H. D. Hatfield Scout

KANSAS

Ellsworth

Map No.

55

Sec.

31

Twp.

17

R.

10^w

Well No.

6-Griggell

Gulf

Company

Contractor

COMPLETED

_____ Ft. from N. Line

990 Ft. from S. Line

_____ Ft. from E. Line

990 Ft. from W. Line

SECTION PLAT

<i>0</i>			

Location _____

Rig up _____

Drilling and Remarks:

2000 A

Pump 1111/12

Pot - 222 2/4

RECORD

Cased *7 in., 3235 ft.*

Sand *S11 3235*

Gas _____

Oil _____

Total Depth *3245*

PRODUCTION

1st 24 hrs. Nat. _____

1st 24 hrs. after shot _____

Gas _____ Cu. Ft.

Dry Hole _____

Abandoned _____

Date

JUN 16 1937

H. D. Hatfield

Scout