


Section 31 Township 17 Range 10-W

Well No. 8 - Grizzell

Company Gulf

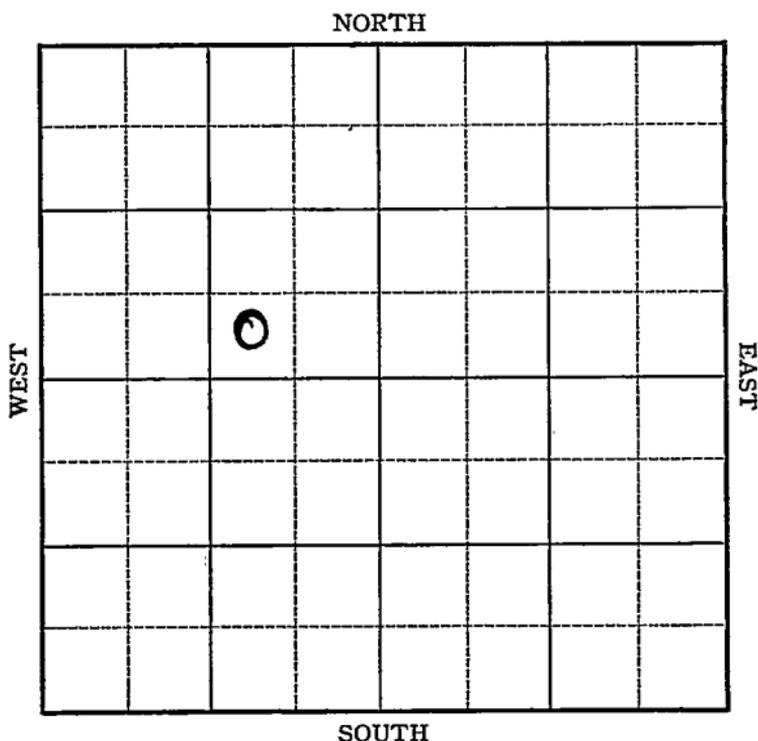

Ellsworth

Map No. 55 Sec. 31 Twp. 17 R. 10 ^WWell No. S-GriggellGulf Company

Contractor

FIRST REPORT

SECTION PLAT

	0		

_____ Ft. from N. Line

330 Ft. from S. Line990 Ft. from E. Line

_____ Ft. from W. Line

Location _____

Rig up _____

Drilling and Remarks: _____

B.R.R.

RECORD

Cased _____ in., _____ ft.

Sand _____

Gas _____

Oil _____

Total Depth _____

PRODUCTION

1st 24 hrs. Nat. _____

1st 24 hrs. after shot _____

Gas _____ Cu. Ft.

Dry Hole _____

Abandoned _____

Date

JUN 9 1937 19 H. D. Hatfield Scout

KANSAS Ellsworth

Map No. _____ Sec. 31 Twp. 17 R. 10W

Well No. S-Griggell

Gulf Company
Contractor

ABANDONED

SECTION PLAT

	0		

_____ Ft. from N. Line

330 Ft. from S. Line

990 Ft. from E. Line

_____ Ft. from W. Line

Location _____

Rig up _____

Drilling and Remarks:

D & A

RECORD

Cased _____ in., _____ ft.

Sand S/1 3312

Gas _____ (corrected)

Oil _____

Total Depth 3491

PRODUCTION

1st 24 hrs. Nat. _____

1st 24 hrs. after shot _____

Gas _____ Cu. Ft.

Dry Hole _____

Abandoned _____

Date

JUL 14 1937 19

H. D. Hatfield

Scout