

KANSAS

Ellsworth

Form 51-5M-7-39-Palace


O. W. P. B.

Section 31 Township 17 Range 10-W

Well No. #6 Moran

Company Skelly

NORTH **Bloomer Pool**

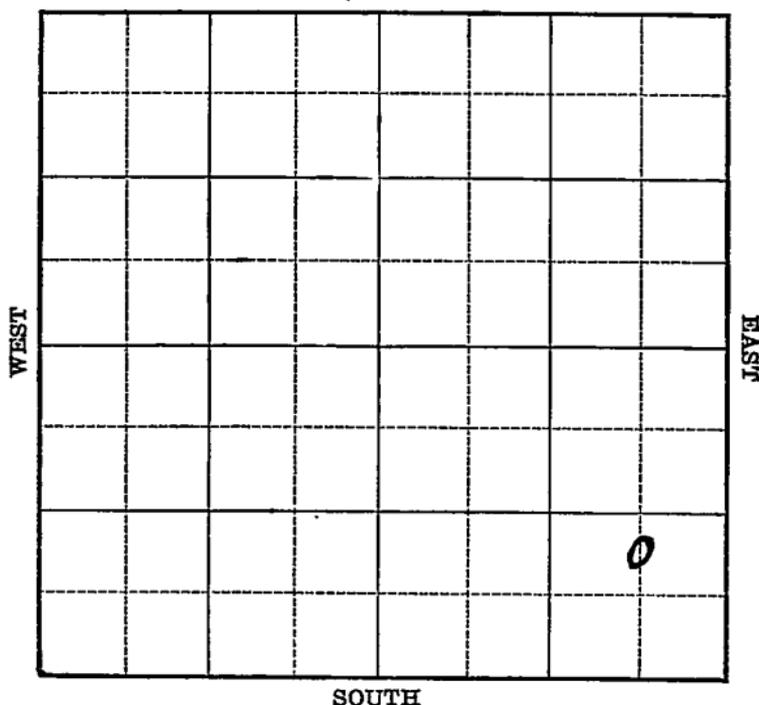

Sec. 31 Twp. 17 R. 10-W

Well No. #6 Moran Farm _____

Skelly Company _____


(Bloomer)

_____ Ft. from N. Line

99.0 Ft. from S. Line

660 Ft. from E. Line

_____ Ft. from W. Line

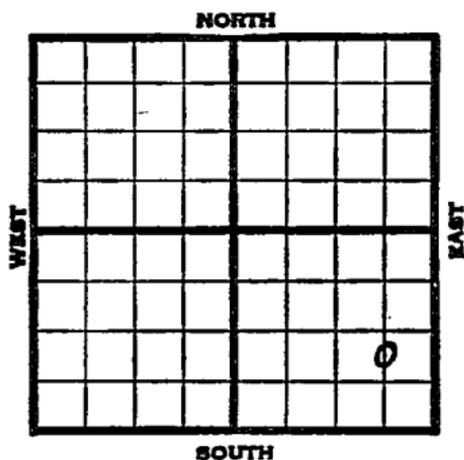

C N/2 SESE
Elev. 1793

1940	REPORT
3/6	Moving in rotary tools.
3/14	8" - 218' Drlg. 1860'
3/21	Lans. 2949' Arb. 3229½'
	T.D. 3232' Run pipe.
3/27	Arb. 3229½'
	5" - 3230½'
	T.D. 3231'
	1000 acid.
	Depthograph potential 3135 bbls.
	Maximum 3000 bbls.
	COMPLETED
	O. W. P. B.
1955	
1/19	Oil Well - TD 3232'
	Lans 2918', Arb. 3221'
	5" @ 3225'
	OTD 3232' - PB 3176'
	33/3135-1/6, 500A
	S/3 bw 4 hrs.
	PB 3105'
	OVER

(Information Brought Forward)

1955
1/19

25/3051-60, 500A

S/6 bw 6 hrs.

35/3015-27, 2 goph, 3500A

PB 2991'

24/2973-80, 500A

S/92 bw 36 hrs.

11/2962-66, 12/2950-54, 500A

B/4 go 7 gw 12 hrs.

PB 2890'

46/2860-68, 1 bwph 17 hrs.

DP 2968, 2500A

S/12 bo 3 bw

DP 3108

48/3094-3108, 1500A

S/14 bwpd

Comp. 40 bopd 40 bw

FIRST REPORT

&

COMPLETED

Map No. 55 Sec. 31 Twp. 17 R. 10W

Well No. 6 Moran

Skelly Company

Contractor

FIRST REPORT

C N L SE SE

SECTION PLAT

_____ Ft. from N. Line

990 Ft. from S. Line

660 Ft. from E. Line

_____ Ft. from W. Line

			o

BLOOMER POOL

Location _____

Rig up _____

Drilling and Remarks:

**Moving in
NOTY TOOLS**

RECORD

Cased _____ in., _____ ft.

Sand _____

Gas _____

Oil _____

Total Depth _____

PRODUCTION

1st 24 hrs. Nat. _____

1st 24 hrs. after shot _____

Gas _____ Cu. Ft.

Dry Hole _____

Abandoned _____

Date

MAR 6 1940 19

S. J. LEWIS Scout

Map No. 58 Sec. 31 Twp. 17 R. 10W

Well No. 6 Moran

Skelly Company

Contractor

COMPLETED

C N L SE SE

SECTION PLAT

			o

 Ft. from N. Line

990 Ft. from S. Line

660 Ft. from E. Line

 Ft. from W. Line

BLOOMER POOL

Location

Rig up

Drilling and Remarks:

Ar 8 3229 1/2
5" @ 3230 1/2
1000 acid
Geograph P & Y
2/33

Maximum 3000

RECORD

Cased in., ft.

Sand

Gas

Oil

Total Depth 3231

PRODUCTION

1st 24 hrs. Nat.

1st 24 hrs. after shot

Gas Cu. Ft.

Dry Hole

Abandoned


Date

MAR 27 1940 19

S. J. LEWIS Scout

O. W. P. B.

County **Ellsworth** State **Kansas**
 Sec. **31** (Blk. Twp.) **17** (Sur. Rge.) **10W** Map No.
 Operator **Skelly Oil**
 Well No. **6** Farm **Agnes Moran**
 Elev. **1793** Location **C N¹/₂ SE SE**

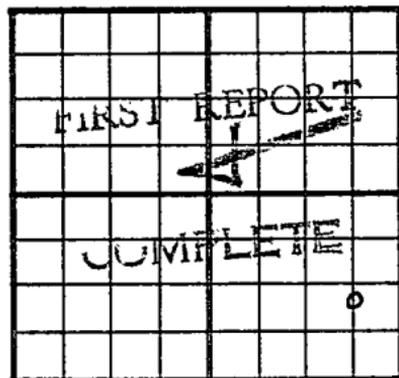

990 Ft. From **S** Line **SE**
 660 Ft. From **E** Line **Quarter**
 Ist. Report **JAN 1 9 1933**
 Completion **JAN 1 1933**
 Remarks **OWPB**
O. W. P. B.
 Spudding Date

Drig. Data **Oil well TD 3232**
Lans. 2948 Arb. 3224 5" @ 3225
OTD 3232 PB 3176 33/ 3135-46 500 A
S/ 3 bw 4 hr. PB 3105 25/ 3051-60
500 A S/ 6 bw 6 hr. 35/ 3015-27
2 goph 3500 A PB 2991 24/ 2973-80
500 A S/ 92 bw 36 hr. 11/ 2962-66
12/ 2950-54 500 A B/ 4 go 7 gw 12 hr.
PB 2890 46/ 2860-68 1 bwph 17 hr.
DP 2968 2500 A S/ 12 bo 3 bw DP 3108
48/ 3094-3108 1500 A S/ 14 bwpd
Comp. 40 bopd 40 bw

FABEN GILSTRAP