

# KANSAS

Form 51-5M-7-40-Palace

Ellsworth

Section 31 Township 17 Range 10-W

Well No. 10 Grizzell


Company Gulf

**Bloomer Pool**

NORTH

WEST

EAST

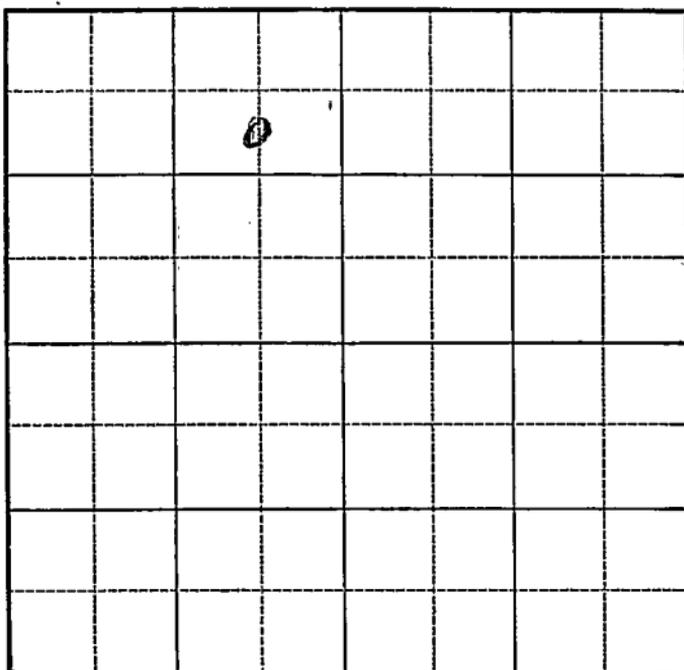

SOUTH

Sec. 31 Twp. 17 R. 10-W

Well No. #10 Grizzell Farm \_\_\_\_\_  
Gulf Company \_\_\_\_\_

(Bloomer)


990 Ft. from N. Line

\_\_\_\_\_ Ft. from S. Line

660 Ft. from E. Line

\_\_\_\_\_ Ft. from W. Line

Elev. 1809

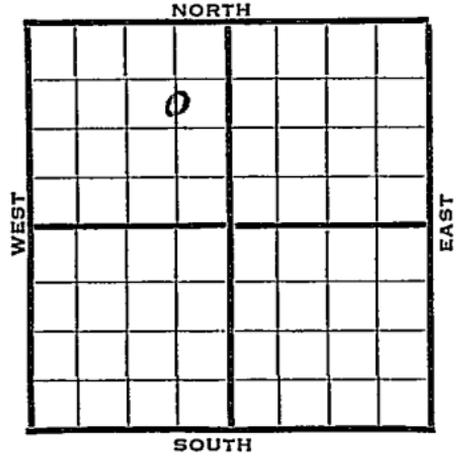

1941	REPORT
1/15	225' running 8".
1/23	8" - 222' Drlg. 2695'
1/31	Lans. 2988' Sat.
	Arb. 3289-91' T.D. 5" - 3291'
	RUST.
2/6	4500 acid. Pump 88 oil & 38 water 24 hours.
2/12	Arb. 3289'
	5" - 3291'
	T.D. 3298'
	4500 acid.
	Pump 16 oil & 5 water.
	42.7 Gravity
	<b>COMPLETED</b>

Map No. 55 Sec. 31 Twp. 17 R. 10W

Well No. 10 Grizzell

Gulf Company

Contractor

**FIRST REPORT**

**SECTION PLAT**

990 **C S L NE NW**  
Ft. from N. Line

\_\_\_\_\_ Ft. from S. Line

660 Ft. from E. Line

\_\_\_\_\_ Ft. from W. Line

	o		

**BLOOMER POOL**

Location \_\_\_\_\_

Rig up \_\_\_\_\_

Drilling and Remarks:

**225' Running 8"**

**RECORD**

Cased \_\_\_\_\_ in., \_\_\_\_\_ ft.

Sand \_\_\_\_\_

Gas \_\_\_\_\_

Oil \_\_\_\_\_

Total Depth \_\_\_\_\_

**PRODUCTION**

1st 24 hrs. Nat. \_\_\_\_\_

1st 24 hrs. after shot \_\_\_\_\_

Gas \_\_\_\_\_ Cu. Ft.

Dry Hole \_\_\_\_\_

Abandoned \_\_\_\_\_

Date

JAN 15 1941

S. J. LEWIS

Scout

Map No. 55 Sec. 31 Twp. 17 R. 10WWell No. 10 GrizzellGulf

Company

Contractor

**COMPLETED**

C S L NE NW

990 Ft. from N. Line

\_\_\_\_\_ Ft. from S. Line

660 Ft. from E. Line

\_\_\_\_\_ Ft. from W. Line

BLOOMER POOL

**SECTION PLAT**

	o		

Location \_\_\_\_\_

Rig up \_\_\_\_\_

Drilling and Remarks:

*Co 8289**5" Co 8291**4500 acid**Pump 16 oil 5 Water**427 Gr***RECORD**

Cased \_\_\_\_\_ in., \_\_\_\_\_ ft.

Sand \_\_\_\_\_

Gas \_\_\_\_\_

Oil \_\_\_\_\_

Total Depth 3298**PRODUCTION**

1st 24 hrs. Nat. \_\_\_\_\_

1st 24 hrs. after shot \_\_\_\_\_

Gas \_\_\_\_\_ Cu. Ft.

Dry Hole \_\_\_\_\_

Abandoned \_\_\_\_\_

Date

FEB 12 1941 19

S. J. LEWIS

Scout