


KANSAS

FORM 51 5M PETROL

Section 31 Township 17 Range 10W

Well No. 11 Moran

Company Skelly

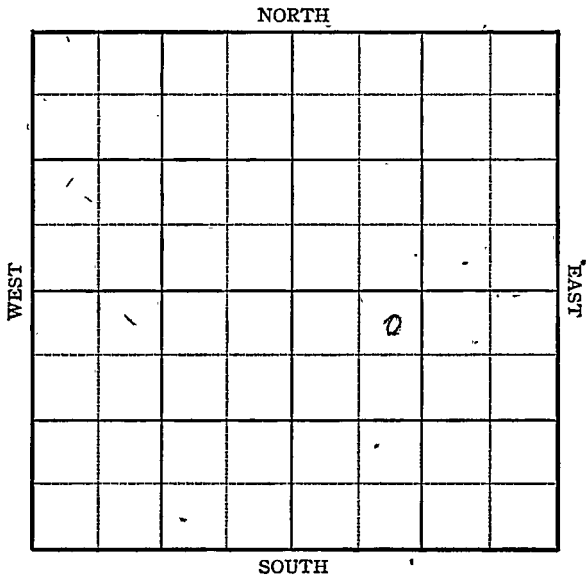

KANSAS

Ellsworth

Sec. 31 Twp. 17 R. 10-W

Well No. #11 Moran Farm


Skelly Company

330 Ft. from N. Line

_____ Ft. from S. Line

_____ Ft. from E. Line

990 Ft. from W. Line

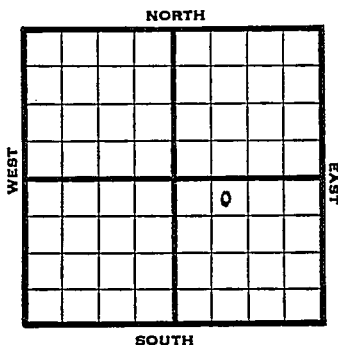

NE NW SE Elev. 1798

1945

REPORT

9/19 Location

9/26 Derrick

10/3 RUR

10/10 8" @ 208' WOC

10/17 Drlg. 2400

10/24 Lāns 2962

Arb. 3234-3244

TD 3244

5" @ 3235 RUST

10/32 Arb. 3234

5" @ 3235

500 acid.

TD 3248

Depth Pot. 2140

Grav. 42.6

COMPLETED

KANSAS
KANSASPool Name BloomerMap No. 55 Sec. 31 Twp. 17 R. 10WWell No. 11 Moran

Skelly

Company

FIRST REPORT

Contractor

NE NW SE

SECTION PLAT

330 Ft. from N. Line Ft. from S. Line Ft. from E. Line990 Ft. from W. Line

		c	

Ellsworth County

RECORD

Location X

Rig up

Drilling and Remarks:

Cased in., ft.Sand Gas Oil Total Depth

PRODUCTION

1st 24 hrs. Nat. 1st 24 hrs. after shot Gas Cu. Ft.Dry Hole Abandoned

Date

SEP 19 1945

S. J. LEWIS

Scout

KANSAS - Kansas Pool Name Bloomer
 Map No. 55 Sec. 31 Twp. 17 R. 10W
 Well No. 11 Moran

Skelly

Company


COMPLETED

Contractor

NE NW SE

E1/798

SECTION PLAT

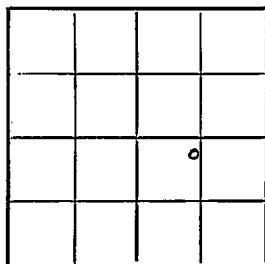330 Ft. from N. Line Ft. from S. Line Ft. from E. Line990 Ft. from W. Line

Ellsworth County

Location

Rig up

Drilling and Remarks:

CR 3234
5" @ 3235
500 acid
Sept 10 1940

42-6

RECORD

Cased in. ft.Sand Gas Oil Total Depth 3248

PRODUCTION

1st 24 hrs. Nat. 1st 24 hrs. after shot Gas Cu. Ft.Dry Hole Abandoned

Date

OCT 31 1945

19

S. J. LEWIS

Scout