

KANSAS


Woodson

FORM 51 5M PETROL

Section 17 Township 24 Range 14E

Well No. 1 Miller

Company C. R. Armstrong & Souder

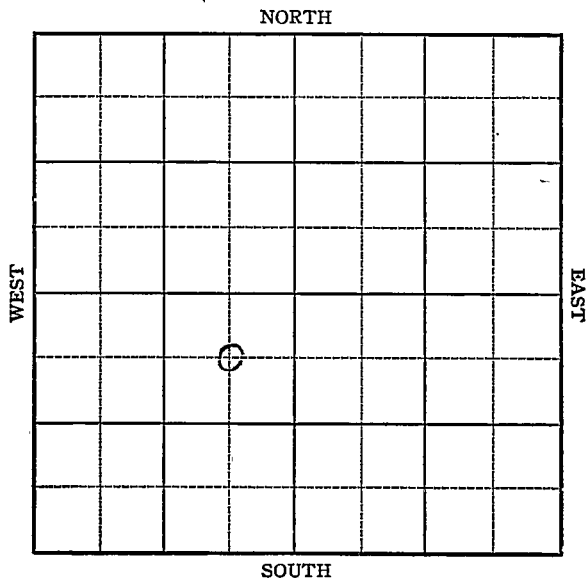

KANSAS

Woodson

Sec. 17 Twp. 24 R. 14E

Well No. 1 Miller Farm

C. R. Armstrong & Souder Company

Miscellaneous


NORTH

660 Ft. from N. Line

_____ Ft. from S. Line

660 Ft. from E. Line

_____ Ft. from W. Line

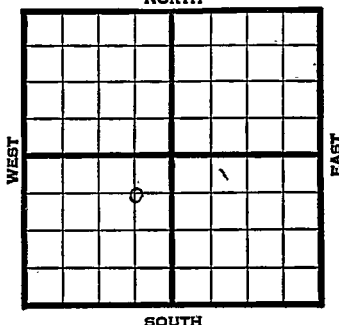

C NE SW

1945

REPORT

5/2 12" -270
8" -1055
Bart 1565-90
SO and W
6" -1600 Crooked
TD 1680 P 1645

5/10 TD 1680
PB 1645
Shut down

5/17 Fishing
5/24 - "

6/6 Miss. 1650
TD 1778

ABANDONED

Kansas Pool Name Miscellaneous

Map No. 17 Sec. 17 Twp. 24 R. 14E

Well No. 1 Miller

C. R. Armstrong & Souder Company

ABANDONED

Contractor

C NE SW

SECTION PLAT

660 Ft. from N. Line

_____ Ft. from S. Line

660 Ft. from E. Line

_____ Ft. from W. Line

	6		

Woodson County

Location _____

Rig up _____

Drilling and Remarks:

Miss 1658

RECORD

Cased _____ in., _____ ft.

Sand _____

Gas _____

Oil _____

Total Depth 1778'

PRODUCTION

1st 24 hrs. Nat. _____

1st 24 hrs. after shot _____

Gas _____ Cu. Ft.

Dry Hole _____

Abandoned _____

Date

JUN 6 1945 19 _____

S. J. LEWIS Scout