


KANSAS Woodson

Section 15 Township 24 Range 14E

Well No. 1 Holmquist

Company Derby Drlg et al

Wildcat

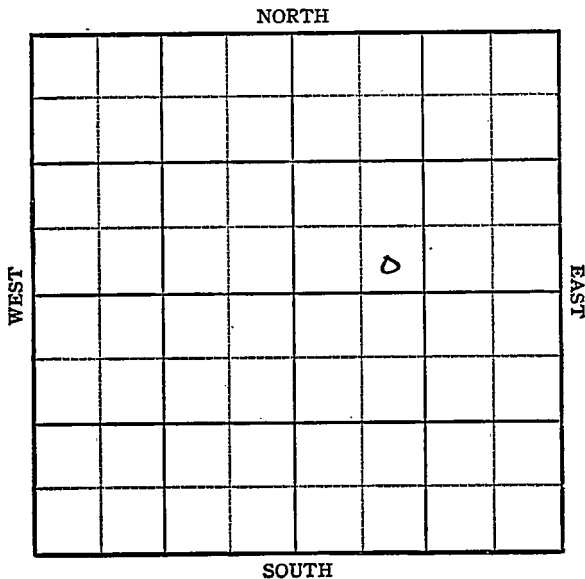

Sec. 15 Twp. 24 R. 14-E ✓

Well No. #1 Holmquist Farm

Dervy Drlg etal. Company


Wildcat

           Ft. from N. Line

330 Ft. from S. Line

           Ft. from E. Line

990 Ft. from W. Line

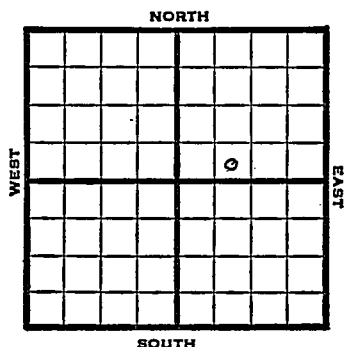

SE SW NE

1949

Elev 1120'

REPORT

1/26

Location

2/2

"

2/9

"

2/16

Mach.

2/23

12" @ 50'

Lansing 480'

Drlg. 860'

3/2

8" @ 1340'

Drlg. 1470'

3/9

TD 1754'

Miss 1639'

Aband.

**ABANDONED**

Map No. \_\_\_\_\_ Sec. 15 Twp. 24 R. 14<sup>E</sup>

Well No. 1 Holmquist


Derby Drlg. etal. Company

**FIRST REPORT**

Contractor

SE SW NE

**SECTION PLAT**

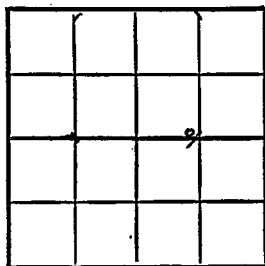

\_\_\_\_\_ Ft. from N. Line

330 Ft. from S. Line

\_\_\_\_\_ Ft. from E. Line

990 Ft. from W. Line

Woodson County

Location X

Rig up \_\_\_\_\_

Drilling and Remarks:

**RECORD**

Cased \_\_\_\_\_ in., \_\_\_\_\_ ft.

Sand \_\_\_\_\_

Gas \_\_\_\_\_

Oil \_\_\_\_\_

Total Depth \_\_\_\_\_

**PRODUCTION**

1st 24 hrs. Nat. \_\_\_\_\_

1st 24 hrs. after shot \_\_\_\_\_

Gas \_\_\_\_\_ Cu. Ft.

Dry Hole \_\_\_\_\_

Abandoned \_\_\_\_\_

Date

JAN 26 1949 19

S. J. LEWIS Scout

Kansas

Map No. K17 Sec. 15 Twp. 24 R. 14EWell No. 1 Holmquist

Derby Drlg. et al.

Company

**ABANDONED**

Contractor

SE SW NE

E1,1120  
SECTION PLAT

Ft. from N. Line

330

Ft. from S. Line

Ft. from E. Line

990

Ft. from W. Line

|  |  |   |  |
|--|--|---|--|
|  |  |   |  |
|  |  |   |  |
|  |  | 0 |  |
|  |  |   |  |
|  |  |   |  |

Woodson County

Location

Rig up

Drilling and Remarks:

No. 1639

## RECORD

Cased \_\_\_\_\_ in., \_\_\_\_\_ ft.

Sand \_\_\_\_\_

Gas \_\_\_\_\_

Oil \_\_\_\_\_

Total Depth 1254

## PRODUCTION

1st 24 hrs. Nat. \_\_\_\_\_

1st 24 hrs. after shot \_\_\_\_\_

Gas \_\_\_\_\_ Cu. Ft.

Dry Hole \_\_\_\_\_

Abandoned \_\_\_\_\_

Date

MAR 9 1949 19

S. J. LEWIS Scout