

WELL LOG

3

COMPANY A. Scott Ritchie
 125 N. Market, Suite 950
 Wichita, KS 67202

FARM Keller **NO. 1**


RIG. NO. 8

TOTAL DEPTH 3700'

COMM. 11-21-85 **COMP.** 11-30-85

CONTRACTOR Murfin Drilling Company
 250 N. Water, Suite 300
 Wichita, KS 67202

SEC. 18 T. 16S R. 16W
LOC. NE NW SW

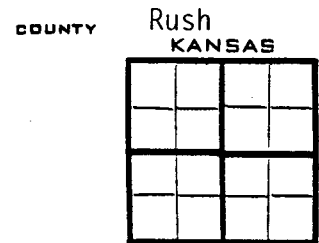

CASING

20 10

15 8 -5/8" set @ 1107' w/425 sx Common, 2% Gel, 3% CC **ELEVATION**

12 6

13 5 -1/2" set @ 3595' w/100 sx 60/40 Poz, 10% Salt **PRODUCTION**

FIGURES INDICATE BOTTOM OF FORMATIONS

Surface Dirt & Shale	980'
Shale	1108'
Anhydrite	1134'
Shale	1935'
Shale & Lime	3550'
Arbuckle	3700'

FEB 03 1986
State Geological Survey
WICHITA BRANCH