


Map No. _____ Sec. 9 Twp. 29 R. 4

Well No. 4 Elder Farm

Empire Company

NORTH

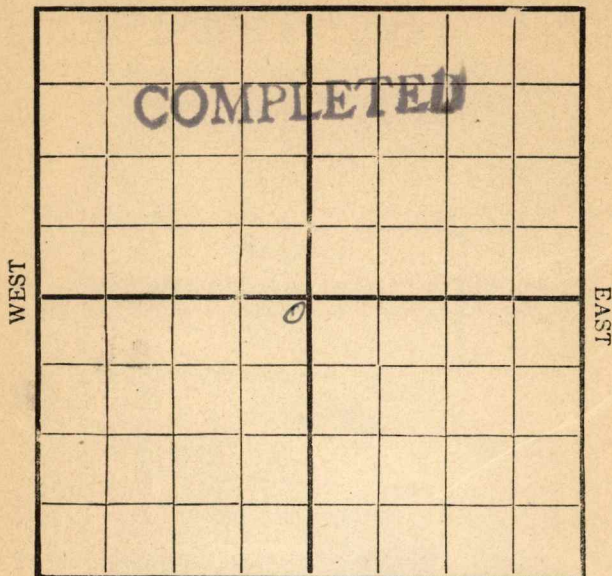

SOUTH

Location -----

Drilling Remarks:

Rig Up-----

Drilling Remarks:

RECORD

Cased_____ in_____Ft.

Sand -----

Gas -----

Oil _____

Total Depth_____

PRODUCTION

1st 24 hrs. Nat_____

1st 24 hrs. after shot-----

Gas-----Cu. Ft


Dry Hole-----

Abandoned -----

Map No. _____ Sec. 9 Twp. 29 R. 4
 Well No. 4 Elder Farm _____
Engine Company _____

NORTH

WEST

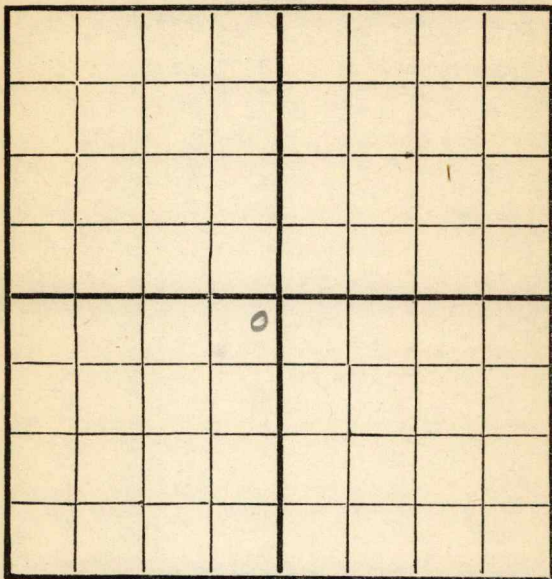

EAST

SOUTH

Location _____
 Rig Up _____
 Drilling and remarks

1470

RECORD

Cased _____ in. _____ Ft.
 Sand _____
 Gas _____
 Oil _____
 Total Depth _____

PRODUCTION

1st 24 hrs. Nat. _____
 1st 24 hrs. after shot _____
 Gas _____ Cu. Ft.
 Dry Hole _____
 Abandoned _____


Date

5/25 191 7 Cardiff

Scout

Map No. _____ Sec. 9 Twp. 29 R. 4
 Well No. 4000 Farm _____
Engine Company _____

NORTH

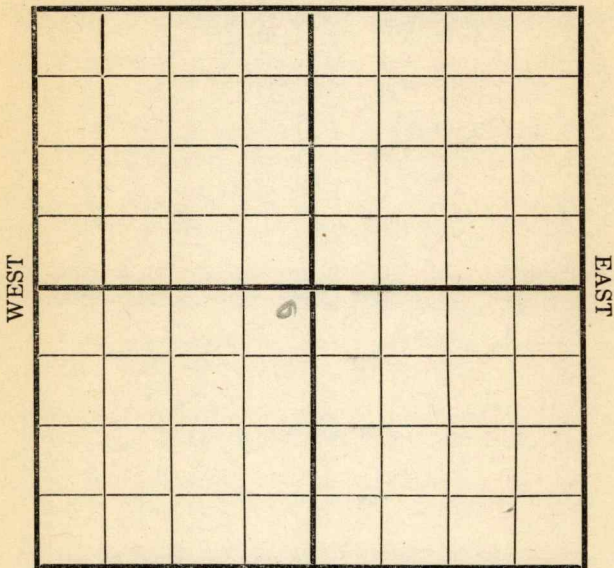

SOUTH

Location _____

Rig Up _____

Drilling and remarks

Shut down
1470

RECORD

Cased _____ in. _____ Ft.

Sand _____

Gas _____

Oil _____

Total Depth _____

PRODUCTION

1st 24 hrs. Nat. _____

1st 24 hrs. after shot _____

Gas _____ Cu. Ft.

Dry Hole _____

Abandoned _____


Date

5/29, 191*7* *C. C. C.* Scout

Map No. _____ Sec. 9 Twp. 29 R. 4
 Well No. 4888 Farm _____
Engine Company _____

NORTH

WEST

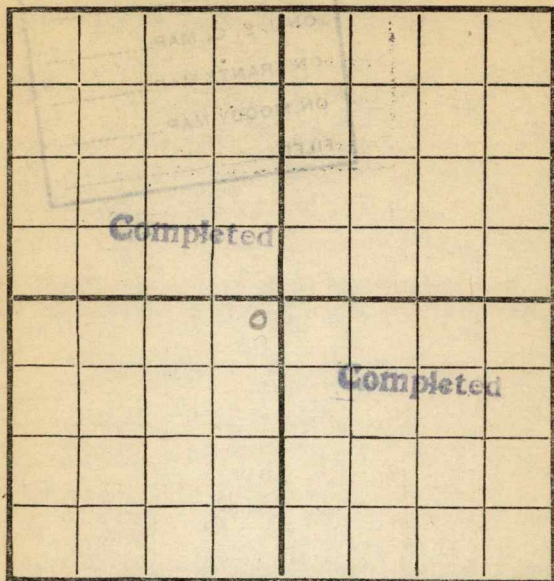

EAST

SOUTH

Location _____

Rig Up _____

Drilling and remarks

Est at
60 Bbls

RECORD

Cased _____ in. _____ Ft.

Sand 1784-1813

Gas _____

Oil _____

Total Depth _____

PRODUCTION

1st 24 hrs. Nat. _____

1st 24 hrs. after shot _____

Gas _____ Cu. Ft.

Dry Hole _____

Abandoned _____


Date

6/8, 1917, Engl Scout

Map No. _____ Sec. 9 Twp. 29 R. 4Well No. 4 Coker Farm _____Empire Company _____

NORTH

WEST

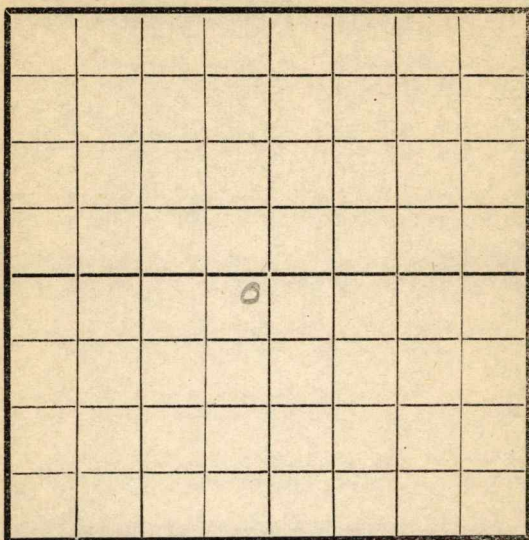

EAST

SOUTH

Location _____

Rig Up _____

Drilling and remarks

going to drill
to deep sand
1813

RECORD

Cased _____ in. _____ Ft

Sand _____

Gas _____

Oil _____

Total Depth _____

PRODUCTION

1st 24 hrs. Nat. _____

1st 24 hrs. after shot _____

Gas _____ Cu. Ft

Dry Hole _____

Abandoned _____


Date

4/17, 1918 S. C. Coker Scout _____

Map No. _____ Sec. 9 Twp. 29 R. 4Well No. 4 Elder Farm_____
Company

NORTH

WEST

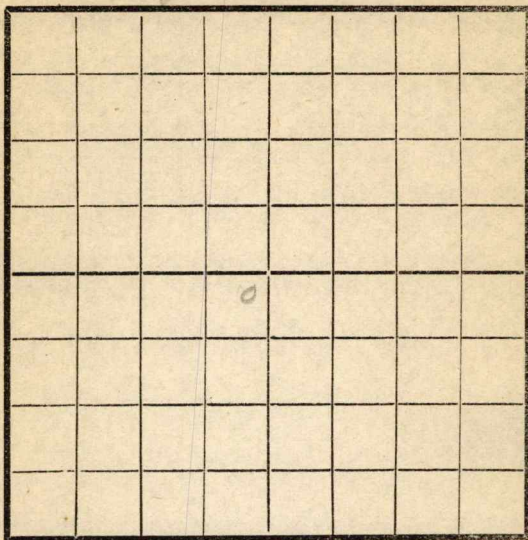

EAST

SOUTH

Location _____

Rig Up _____

Drilling and remarks

SD 1813

RECORD

Cased _____ in _____ Ft.

Sand _____

Gas _____

Oil _____

Total Depth _____

PRODUCTION

1st 24 hrs. Nat. _____

1st 24 hrs. after shot _____

Gas _____ Cu. Ft.

Dry Hole _____

Abandoned _____


Date

4/24, 1918 S. C. Elder Scout

Map No. _____ Sec. 9 Twp. 29 R. 4Well No. 4 Elder Farm _____Company _____

NORTH

WEST

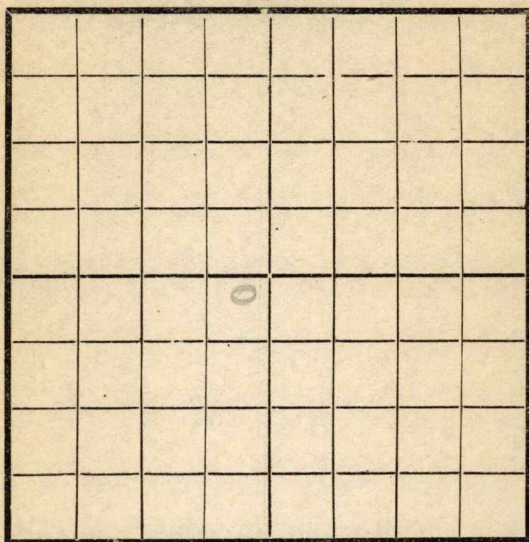

EAST

SOUTH

RECORD

Location _____

Cased _____ in _____ Ft.

Rig Up _____

Sand _____

Drilling and remarks

Gas _____

Oil _____

Total Depth _____

PRODUCTION

1st 24 hrs. Nat. _____

1st 24 hrs. after shot _____

Gas _____ Cu. Ft.

Dry Hole _____

Abandoned _____


Date

5/1, 1918 Scout

Map No. _____ Sec. 9 Twp. 29 R. 4Well No. 4 E Elder Farm _____Enterprise Company _____

NORTH

WEST

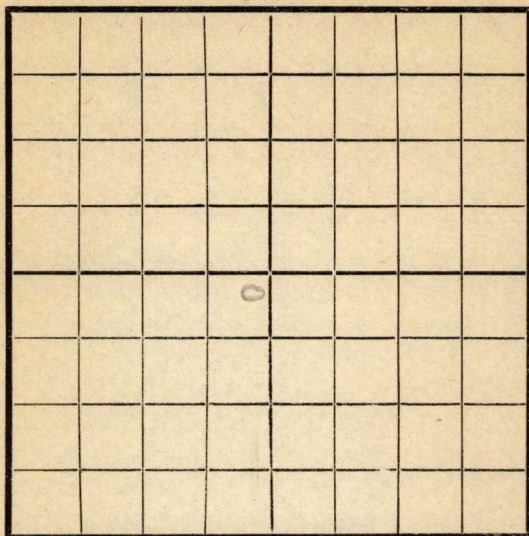

EAST

SOUTH

RECORD

Location _____

Cased _____ in. _____ Ft.

Rig Up _____

Sand _____

Drilling and remarks

Gas _____

Oil _____

Total Depth _____

PRODUCTION

1st 24 hrs. Nat. _____

1st 24 hrs. after shot _____

Gas _____ Cu. Ft.

Dry Hole _____

Abandoned _____


Date

578.8, 1918 Condyff Scout

Map No. _____ Sec. 9 Twp. 29 R. 4Well No. 4 Elder Farm _____Empire Company _____

NORTH

WEST

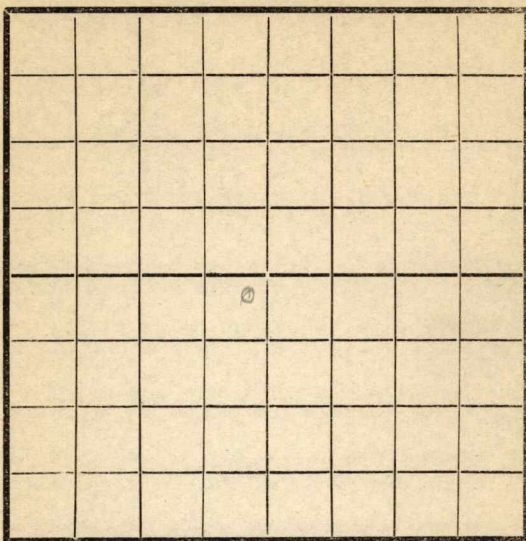

EAST

SOUTH

Location _____

Rig Up _____

Drilling and remarks

*cleaning
out old
hole
1813*

RECORD

Cased _____ in. _____ Ft.

Sand _____

Gas _____

Oil _____

Total Depth _____

PRODUCTION

1st 24 hrs. Nat. _____

1st 24 hrs. after shot _____

Gas _____ Cu. Ft.

Dry Hole _____

Abandoned _____


Date

5/15, 1918 J. C. Candy Scout

Map No. _____ Sec. 9 Twp. 29 R. 4Well No. 48-Eden Farm _____Company Eden

NORTH

WEST

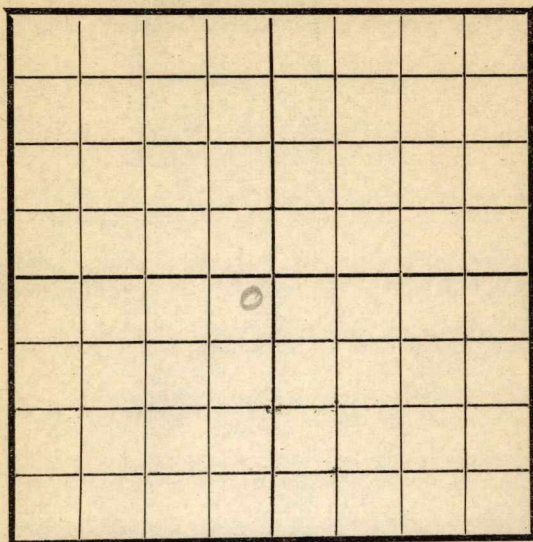

EAST

SOUTH

Location _____

Rig Up _____

Drilling and remarks

RECORD

Cased _____ in. _____ Ft.

Sand _____

Gas _____

Oil _____

Total Depth _____

PRODUCTION

1st 24 hrs. Nat. _____

1st 24 hrs. after shot _____

Gas _____ Cu. Ft.

Dry Hole _____

Abandoned _____

Date

5/22, 1918 Eden Scout

Map No. _____ Sec. 9 Twp. 29 R. 4


Well No. 4 Elder Farm _____

_____ Company _____

NORTH

WEST

EAST

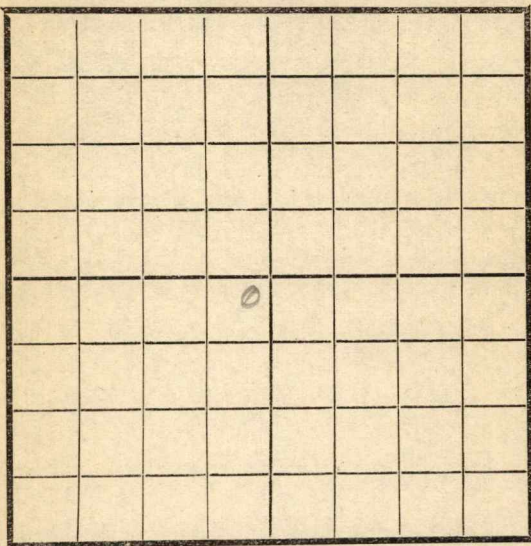

SOUTH

Location _____

Rig Up _____

Drilling and remarks

1890

RECORD

Cased _____ in. _____ Ft.

Sand _____

Gas _____

Oil _____

Total Depth _____

PRODUCTION

1st 24 hrs. Nat. _____

1st 24 hrs. after shot _____

Gas _____ Cu. Ft.

Dry Hole _____

Abandoned _____

Date


5/29, 1918

Scout

Map No. _____ Sec. 9 Twp. 29 R. 4Well No. 4 E. 100

_____ Company

_____ Contractor

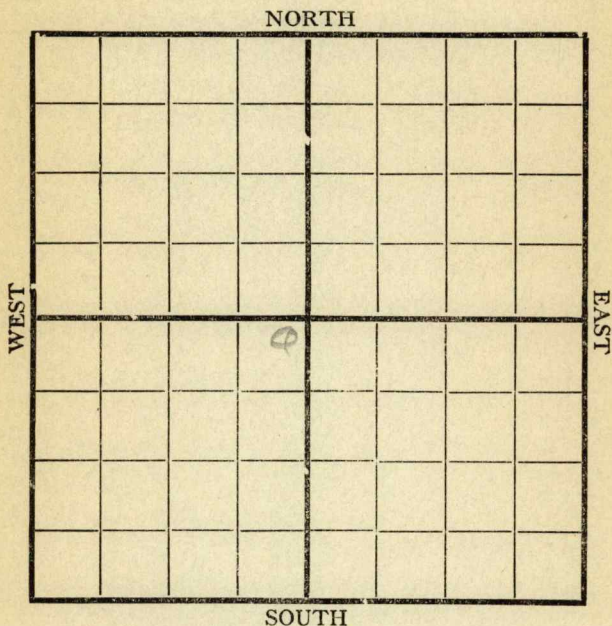

Location _____

Rig up _____

Drilling and Remarks:

2140**RECORD**

Cased _____ in., _____ ft.

Sand _____

Gas _____

Oil _____

Total Depth _____

PRODUCTION

1st 24 hrs. Nat. _____

1st 24 hrs. after shot _____

Gas _____ Cu. Ft.

Dry Hole _____

Abandoned _____

Date

6/51918J. C. Condy

Scout


Map No. _____ Sec. 9 Twp. 39 R. 4Well No. 4 Elder

_____ Company

_____ Contractor

NORTH

WEST

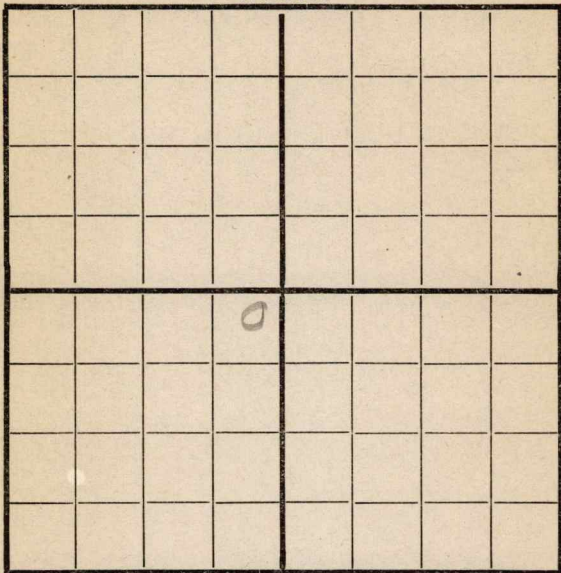

EAST

SOUTH

Location _____

Rig up _____

Drilling and Remarks:

2430**RECORD**

Cased _____ in., _____ ft.

Sand _____

Gas _____

Oil _____

Total Depth _____

PRODUCTION

1st 24 hrs. Nat. _____

1st 24 hrs. after shot _____

Gas _____ Cu. Ft.


Dry Hole _____

Abandoned _____

Date

6/12 191 S. R. R. R. Scout

Map No. _____ Sec. 9 Twp. 29 R. 4
 Well No. 4 C Elder
Engine _____ Company _____
 _____ Contractor _____

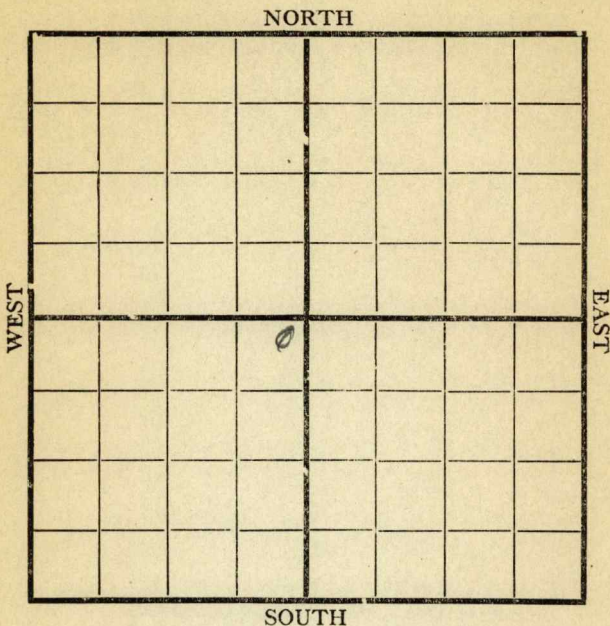

	RECORD
Location _____	Cased _____ in., _____ ft.
Rig up _____	Sand _____
Drilling and Remarks:	Gas _____
2550	Oil _____
	Total Depth _____
	PRODUCTION
	1st 24 hrs. Nat. _____
	1st 24 hrs. after shot _____
	Gas _____ Cu. Ft.
	Dry Hole _____
	Abandoned _____


Date 6/19 1918 J. C. Elder Scout

Map No. _____ Sec. 9 Twp. 29 R. 4

Well No. 4 E - 100

Engine Company

Contractor

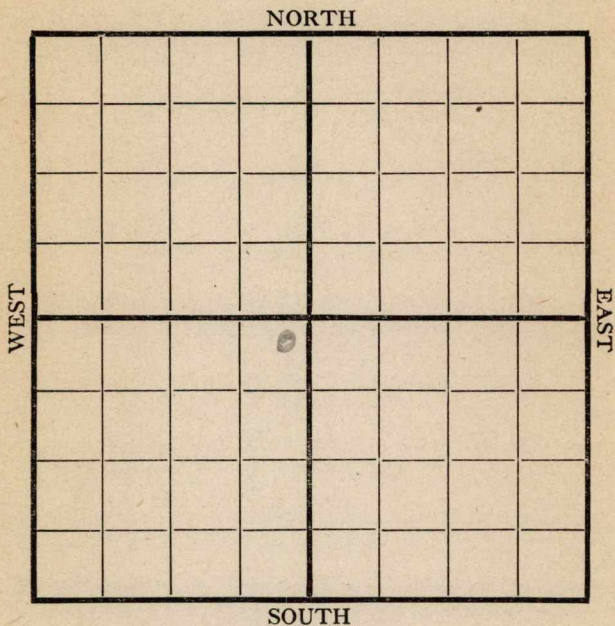

Location _____

Rig up _____

Drilling and Remarks:

2850

RECORD

Cased _____ in., _____ ft.

Sand _____

Gas _____

Oil _____

Total Depth _____

PRODUCTION

1st 24 hrs. Nat. _____

1st 24 hrs. after shot _____

Gas _____ Cu. Ft.

Dry Hole _____

Abandoned _____

Date

6/26 1918 C. Conley Scout

Butler
 K11 MAP No. **KANSAS** SEC. *9* TWP. *29S* R. *4E*
 WELL No. *Y Elder*
Empire COMPANY

CONTRACTOR

SECTION PLAT

ABANDONED

_____ FT. FROM N. LINE
 _____ FT. FROM S. LINE
 _____ FT. FROM E. LINE
 _____ FT. FROM W. LINE

	0		

LOCATION _____

RIG UP _____

DRILLING AND REMARKS:

RECORD

CASED _____ IN. _____ FT.
 SAND _____
 GAS _____
 OIL _____
 TOTAL DEPTH *2911*

PRODUCTION

1ST 24 HRS. NAT. _____
 1ST 24 HRS. AFTER SHOT _____
 GAS _____ CU. FT.
 DRY HOLE ☒
 ABANDONED ☒

DATE

2/1 19*18* _____ SCOUT

