


Map No. _____ Sec. 9 Twp. 29 R. 4E
 Well No. 1- Hartner Farm _____
Buffington & Hodge Company

NORTH

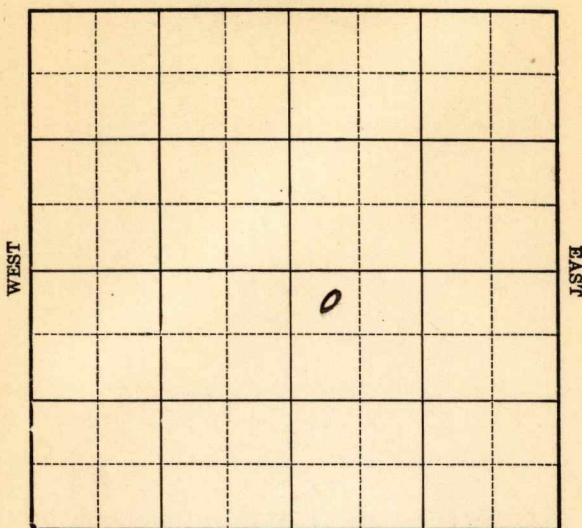

SOUTH

Twin Well

Location _____

Drilling Remarks _____

Rig Up _____

Drilling Remarks _____

RECORD

Cased _____ in. _____ ft.

Sand _____

Gas _____

Oil _____

Total Depth _____

PRODUCTION

1st 24 hrs. Nat. _____

1st 24 hrs. after shot _____

Gas _____ cu. ft.

Dry Hole _____

Abandoned _____

Butler

Map No. KANSAS Sec. 9 Twp. 29 R. 4E

Well No. 1- Hart Farm

Buffington & Hodge Company


NORTH

330 Ft. from N. Line

_____ Ft. from S. Line

_____ Ft. from E. Line

330 Ft. from W. Line

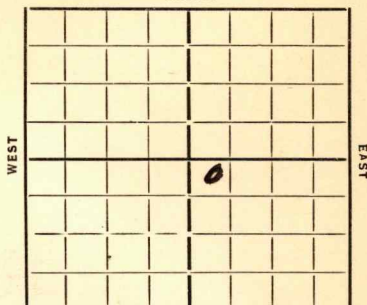

TWIN WELL SOUTH

Date 7/25

REPORT

4/24 Rgn
5/7 5/9-5/16-
5/23 1000 ft
5/29 6/6-
6/13 1600 6" 1590
6/20 1810 20 1790
6/28 7/3-
7/10 1775
Oil 1792-95
T 7 1798
1000 acid
20 Bbls

COMPLETED

KANSAS

Map No. 11 Sec. 9 Twp. 29 R. 4 EWell No. 1-HarterBuffington + Hodge CompanyTwin well Contractor

FIRST REPORT

SECTION PLAT

		0	

330 Ft. from N. Line

..... Ft. from S. Line

..... Ft. from E. Line

330 Ft. from W. Line

Location.....

Rig up.....

Drilling and Remarks:

Rign

RECORD

Cased.....in.,ft.

Sand.....

Gas.....

Oil.....

Total Depth.....

PRODUCTION

1st 24 hrs. Nat.....

1st 24 hrs. after shot.....

Gas.....Cu. Ft.

Dry Hole.....

Abandoned.....

Date

ORVAL MANN SCHRECK

4-24-35 192..... Scout

KANSAS

Map No. 11 Sec. 9 Twp. 29 R. 4 E

Well No. 1-Harter

Buffington & Hodges Company

Contractor

COMPLETED

SECTION PLAT

		0	

330 Ft. from N. Line

..... Ft. from S. Line

..... Ft. from E. Line

330 Ft. from W. Line

RECORD

Location.....

Cased..... in., ft.

Rig up.....

Sand K.C. 1775

Drilling and Remarks:

Gas.....

Oil 1792-95

Total Depth 1798

1000 and

20 ffls

PRODUCTION

1st 24 hrs. Nat.....

1st 24 hrs. after shot.....

Gas..... Cu. Ft.

Dry Hole.....

Abandoned.....

Date

ORVAL MANNSCHRECK

7-10-35 192..... Scout