


Section 18 Township 24 Range 11E

Well No. 1 Kimbel

Company Rigney

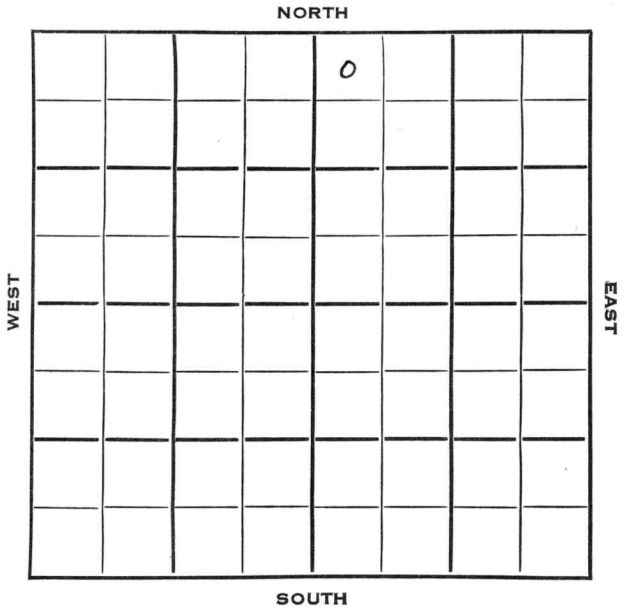

Sec. 18 Twp. 24 R. 14 E

Well No. # 1 Kimbel Farm

Rigney Company

Contractor


250 Ft. from N. Line

\_\_\_\_\_ Ft. from S. Line

\_\_\_\_\_ Ft. from E. Line

150 Ft. from W. Line

NW NW NE

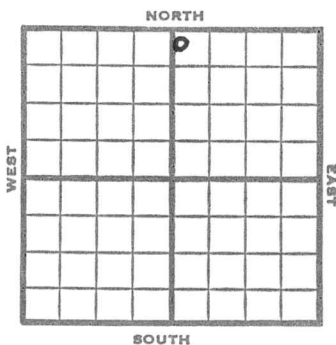

1953

Elev. 1174'

REPORT

1/21

Spud 1-5-53

Lans. 542' KC 855' Oswego 1245'

Bart 1570' Miss 1670'

5" @ 1709'

2/11

Spudding Date 1/5/53

D&A TD 1717

Lans. 542 KC 855 Oswego 1245

Bart. 1570 Miss. 1670 5" @ 1709

TD 1717 1 go 4 hr.

D&A

**ABANDONED**



