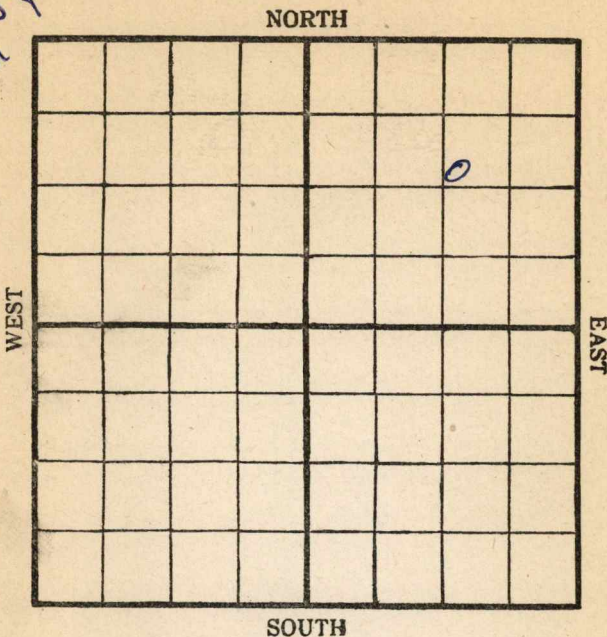


Map No. _____ Sec. 9 Twp. 29 R. 4Well No. 2. Minor Farm _____Ohio Oil Company _____Location tickets

Rig Up _____

Drilling Remarks:

Drilling Remarks:

RECORD

Cased _____ in. _____ ft.

Sand _____

Gas _____

Oil _____

Total Depth 1798

PRODUCTION

1st 24 hrs. Nat. 300 bbls.

1st 24 h.s. after shot _____


Gas 1/2 Million cu. ft

Dry Hole _____

Abandoned _____

Map No. 2 Sec. 9 Twp. 29 R. 4Well No. 1- Minus FarmOhio Oil Company

NORTH

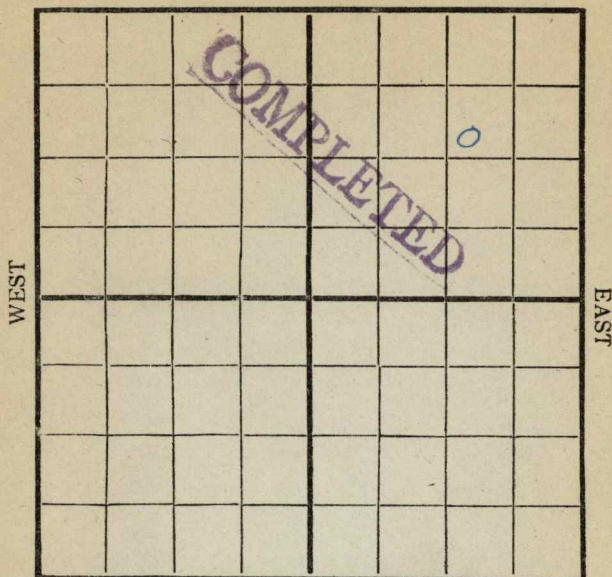

SOUTH

Location 10/5/16Rig Up 10/14/16

Drilling Remarks:

10/5/16 - Drums in10/21 - 10/28 - 11/4 - 11/18Spudling - 11/25 -400 - 12/2 -750 - 12/91240 - 12/23 - 12/301/7/17 - S & D

Drilling Remarks:

RECORD

Cased _____ in _____ Ft.

Sand _____

Gas _____

Oil Est. 100 bbl. 7/13

Total Depth _____

PRODUCTION

1st 24 hrs. Nat. _____

1st 24 hrs. after shot _____

Gas _____ Cu. Ft.

Dry Hole _____

Abandoned _____


Butler

Map No. _____ Sec. 9 Twp. 29 R. 4

Well No. #1 Minor Farm _____

Ohio Oil Company

NORTH

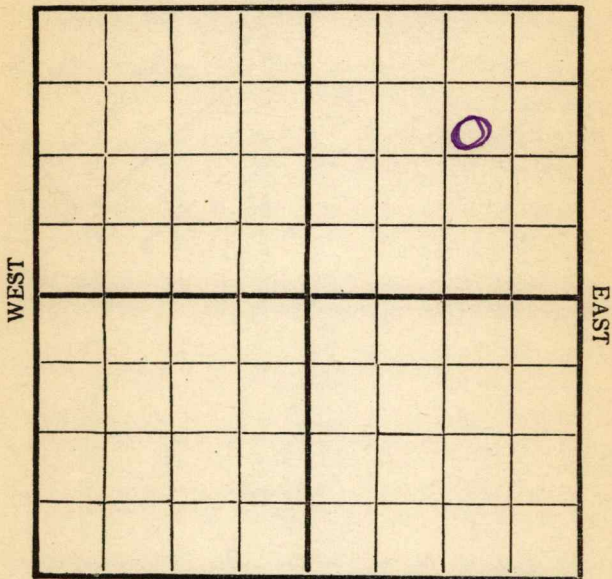

SOUTH

Location ✓

Rig Up _____

Drilling and remarks

Timbers on ground

RECORD

Cased _____ in. _____ Ft.

Sand _____

Gas _____

Oil _____

Total Depth _____

PRODUCTION

1st 24 hrs. Nat. _____

1st 24 hrs. after shot _____

Gas _____ Cu. Ft.

Dry Hole _____

Abandoned _____

Date

10/5, 191 6


Harvest

Scout

Map No. Butler Sec. 9 Twp. 29 R. 4
 Well No. 1 Minor Farm _____
Ohio Oil Company _____

NORTH

WEST

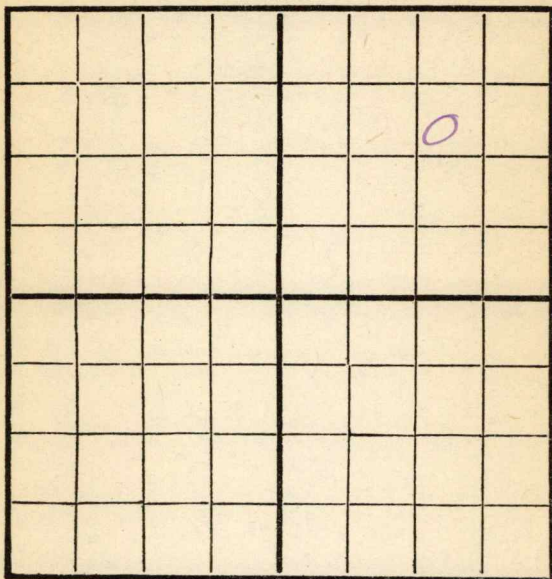

EAST

SOUTH

Location ✓

Rig Up _____

Drilling and remarks

timbers on ground

RECORD

Cased _____ in. _____ Ft.

Sand _____

Gas _____

Oil _____

Total Depth _____

PRODUCTION

1st 24 hrs. Nat. _____

1st 24 hrs. after shot _____

Gas _____ Cu. Ft.

Dry Hole _____

Abandoned _____

Date

10/7, 1916Ernest

Scout


Map No. Butler Sec. 9 Twp. 29 R. 4

Well No. 1 Minor Farm

Ohio Oil Company

NORTH

WEST

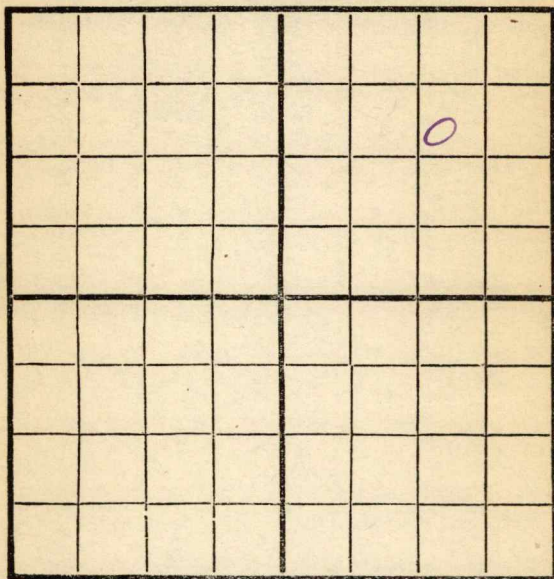

EAST

SOUTH

Location ✓

Rig Up ✓

Drilling and remarks

RECORD

Cased _____ in. _____ Ft.

Sand _____

Gas _____

Oil _____

Total Depth _____

PRODUCTION

1st 24 hrs. Nat. _____

First 24 hrs. after shot _____

Gas _____ Cu. Ft.

Dry Hole _____

Abandoned _____

Date

10/14

191 6


E. H. West

Scout

BUTLERMap No. _____ Sec. 9 Twp. 29 R. 4Well No. 1 Minor Farm __________ Ohio Oil Company

NORTH

WEST

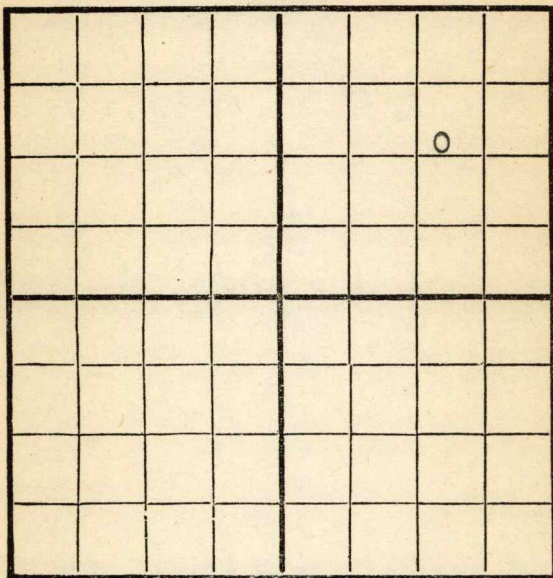

EAST

SOUTH

Location _____

Rig Up _____ ✓

Drilling and remarks _____

RECORD

Cased _____ in. _____ Ft.

Sand _____

Gas _____

Oil _____

Total Depth _____

PRODUCTION

1st 24 hrs. Nat. _____

First 24 hrs. after shot _____

Gas _____ Cu. Ft.

Dry Hole _____

Abandoned _____


Date

OCT 21, 1916 E. H. WEST Scout

BUTLERMap No. _____ Sec. 9 Twp. 29 R. 4Well No. 1 Minor Farm __________ Ohio Oil Company

NORTH

WEST

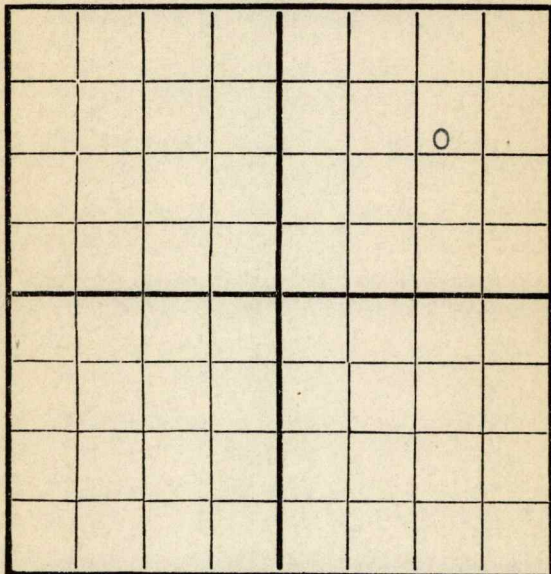

EAST

SOUTH

Location _____

Rig Up / _____

Drilling and remarks _____

RECORD

Cased _____ in. _____ Ft.

Sand _____

Gas _____

Oil _____

Total Depth _____

PRODUCTION

1st 24 hrs. Nat. _____

1st 24 hrs. after shot _____

Gas _____ Cu. Ft.

Dry Hole _____

Abandoned _____

Date

OCT 28 1916**E. H. WEST**


191 _____

Scout

Butler
 Map No. _____ Sec. *9* Twp. *29* R. *4*
 Well No. *1 Minor* Farm _____
 _____ *Ohio Oil* Company

NORTH

WEST

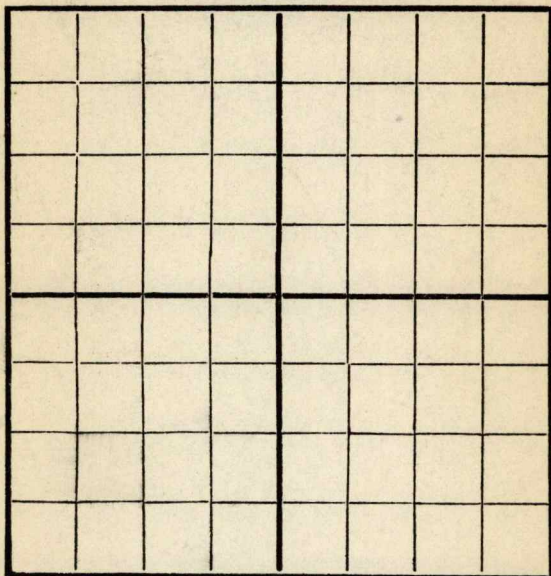

EAST

SOUTH

Location _____

Rig Up *✓* _____

Drilling and remarks _____

RECORD

Cased _____ in. _____ Ft.

Sand _____

Gas _____

Oil _____

Total Depth _____

PRODUCTION

1st 24 hrs. Nat. _____

1st 24 hrs. after shot _____

Gas _____ Cu. Ft.

Dry Hole _____

Abandoned _____


Date

11/4, 191 *6**E. H. WEST* Scout

BUTLERMap No. _____ Sec. 9 Twp. 29 R. 4Well No. 1 Minor _____ Farm __________ Ohio Oil _____ Company

NORTH

WEST

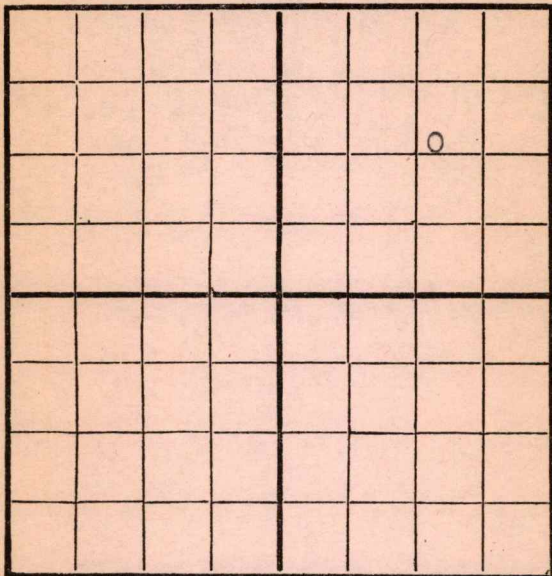

EAST

SOUTH

Location _____

Rig Up _____

Drilling and remarks _____

RECORD

Cased _____ in. _____ Ft.

Sand _____

Gas _____

Oil _____

Total Depth _____

PRODUCTION

1st 24 hrs. Nat. _____

1st 24 hrs. after shot _____

Gas _____ Cu. Ft.

Dry Hole _____

Abandoned _____

Date

NOV 11 1916


191 _____

E. H. WEST Scout

BUTLERMap No. _____ Sec. 9 Twp. 29 R. 4Well No. 1 Minor _____ Farm_____ Ohio Oil _____ Company

NORTH

WEST

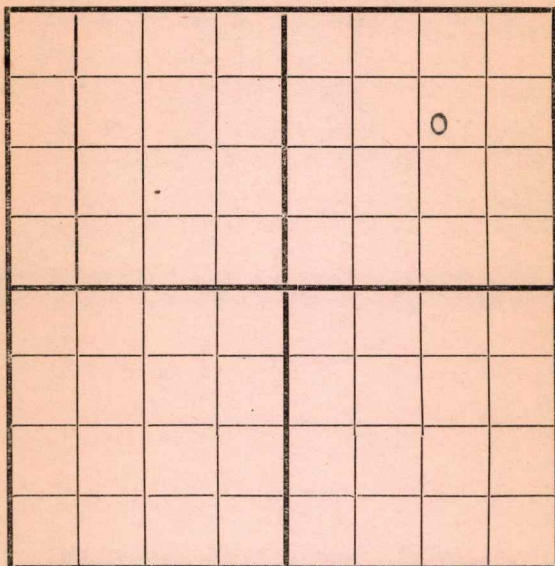

EAST

SOUTH

RECORD

Location _____

Rig Up / _____

Drilling and remarks _____

Cased _____ in. _____ Ft.

Sand _____

Gas _____

Oil _____

Total Depth _____

PRODUCTION

1st 24 hrs. Nat. _____

1st 24 hrs. after shot _____

Gas _____ Cu. Ft.

Dry Hole _____

Abandoned _____

Date

NOV 18 1916

191


E. H. WEST

Scout

BUTLERMap No. _____ Sec. 9 Twp. 29 R. 4Well No. 1 Minor _____ Farm __________ Ohio Oil Company

NORTH

WEST

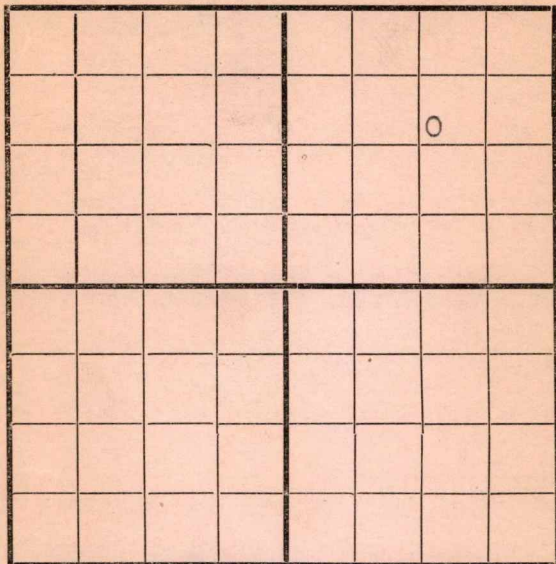

EAST

SOUTH

Location _____

Rig Up _____

Drilling and remarks

*Spudding***RECORD**

Cased _____ in. _____ Ft.

Sand _____

Gas _____

Oil _____

Total Depth _____

PRODUCTION

1st 24 hrs. Nat. _____

1st 24 hrs. after shot _____

Gas _____ Cu. Ft.

Dry Hole _____

Abandoned _____

Date

NOV 25 1916

191


E. H. WEST

Scout

BUTLERMap No. _____ Sec. 9 Twp. 29 R. 4Well No. 1 Minor Farm _____Ohio Oil Company

NORTH

WEST

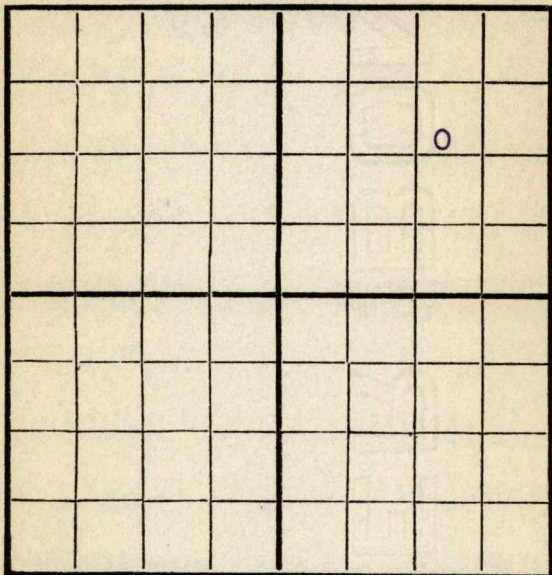

EAST

SOUTH

Location _____

Rig Up _____

Drilling and remarks

400

RECORD

Cased _____ in. _____ Ft.

Sand _____

Gas _____

Oil _____

Total Depth _____

PRODUCTION

1st 24 hrs. Nat. _____

1st 24 hrs. after shot _____

Gas _____ Cu. Ft.

Dry Hole _____

Abandoned _____

Date

DEC - 2 1916E. H. WEST


Scout

BUTLER

Map No. _____ Sec. 9 Twp. 29 R. 4
 Well No. 1 minor Farm _____
 _____ Ohio Oil Company

NORTH

WEST

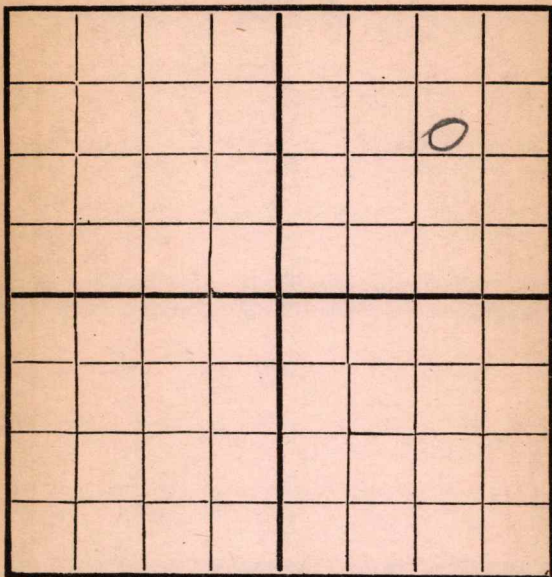

EAST

SOUTH

Location _____
 Rig Up _____
 Drilling and remarks _____

750

RECORD

Cased _____ in. _____ Ft.
 Sand _____
 Gas _____
 Oil _____
 Total Depth _____

PRODUCTION

1st 24 hrs. Nat. _____
 1st 24 hrs. after shot _____
 Gas _____ Cu. Ft.
 Dry Hole _____
 Abandoned _____

Date DEC - 9 1916

E. H. WEST

191


Scout

BUTLERMap No. _____ Sec. 9 Twp. 29 R. 4Well No. 2 minor Farm _____Ohio Oil Company
#1 old dry hole

NORTH

WEST

EAST

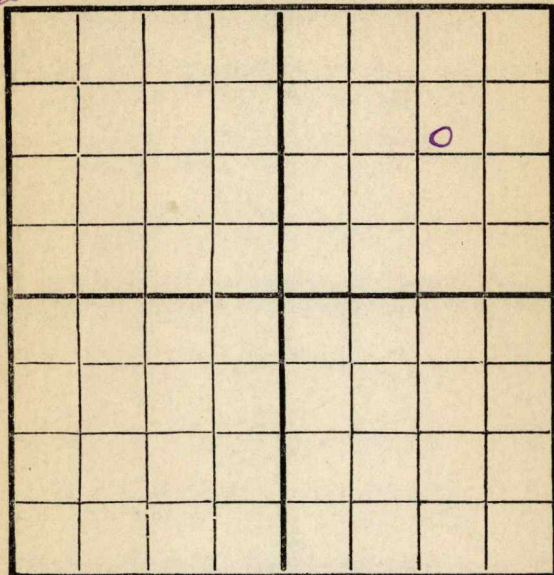

SOUTH

Location _____

Rig Up _____

Drilling and remarks
1000**RECORD**

Cased _____ in. _____ Ft.

Sand _____

Gas _____

Oil _____

Total Depth _____

PRODUCTION

1st 24 hrs. Nat. _____

1st 24 hrs. after shot _____

Gas _____ Cu. Ft.

Dry Hole _____

Abandoned _____

Date

DEC 16 1916

191


E. H. WEST

Scout

BUTLER

Map No. _____ Sec. 9 Twp. 29 R. 4Well No. 2 Minor Farm _____Ohio Oil Company

NORTH

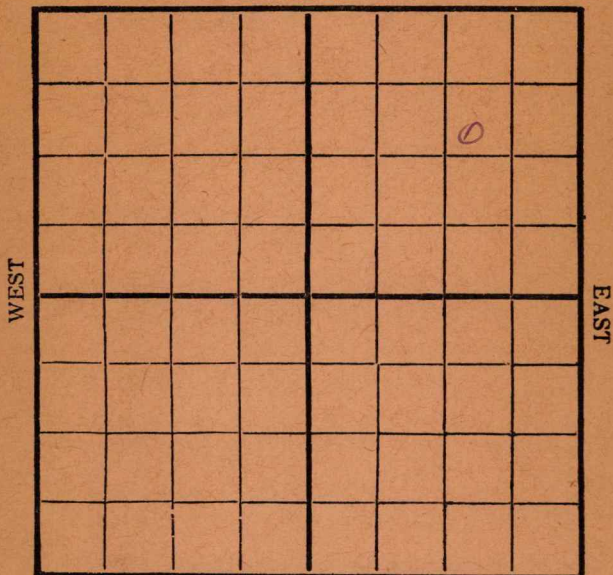

SOUTH

Location _____

Rig Up _____

Drilling and remarks

SD - 1240 feet

RECORD

Cased _____ in. _____ Ft.

Sand _____

Gas _____

Oil _____

Total Depth _____

PRODUCTION

1st 24 hrs. Nat. _____

1st 24 hrs. after shot _____

Gas _____ Cu. Ft.

Dry Hole _____

Abandoned _____

Date

DEC 23 1916

, 191


E. H. WEST

Scout

BUTLER

Map No. _____ Sec. 9 Twp. 29 R. 4Well No. 2 Minor Farm _____Ohio Company _____

NORTH

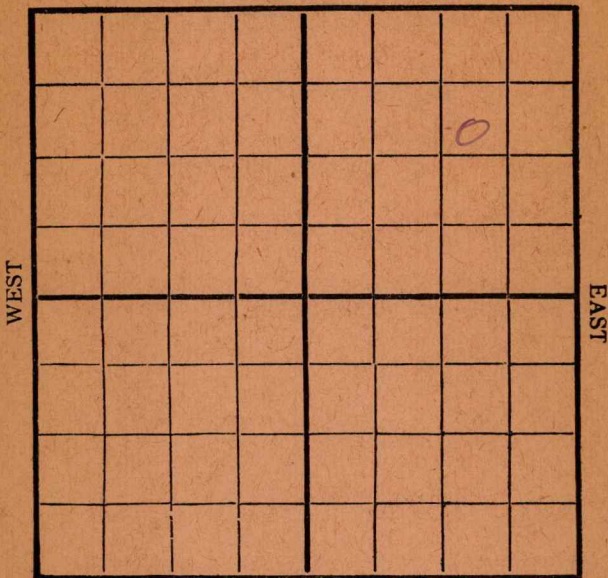

SOUTH

Location _____

Rig Up _____

Drilling and remarks _____

SD-1240

RECORD

Cased _____ in. _____ Ft.

Sand _____

Gas _____

Oil _____

Total Depth _____

PRODUCTION

1st 24 hrs. Nat. _____

1st 24 hrs. after shot _____

Gas _____ Cu. Ft.

Dry Hole _____

Abandoned _____

Date

DEC 30 1916

E. H. WEST

191 _____


Scout

BUTLER

Map No. _____ Sec. 9 Twp. 29 R. 4Well No. 2 minor Farm __________ Ohio Oil Company

NORTH

WEST

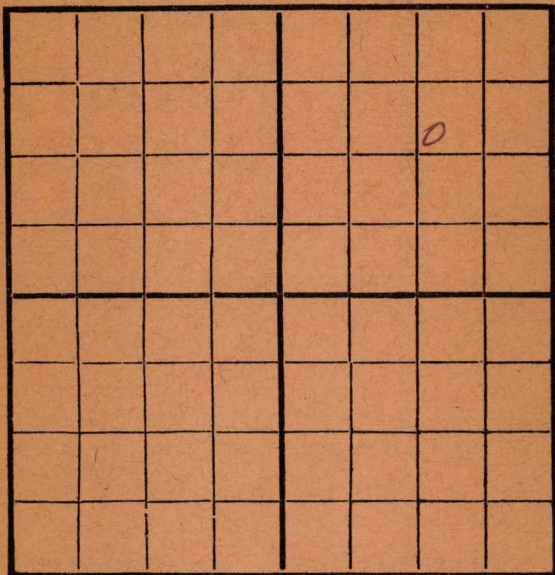

EAST

SOUTH

Location _____

Rig Up _____

Drilling and remarks

SD-1240

RECORD

Cased _____ in. _____ Ft.

Sand _____

Gas _____

Oil _____

Total Depth _____

PRODUCTION

1st 24 hrs. Nat. _____

1st 24 hrs. after shot _____

Gas _____ Cu. Ft.

Dry Hole _____

Abandoned _____

Date

JAN - 6 1917

_____, 191_____

E. H. WEST Scout

BUTLER

Map No. _____ Sec. 7 Twp. 29 R. 4

Well No. 2 Minos Farm _____

Company

NORTH

WEST

EAST

SOUTH

Location _____

Rig Up-----

Drilling and remarks

Now waiting to
see what well
will make before
drilling further

RECORD

Cased _____ in. _____ Ft.

Sand 1778 - 1796

Gas 1/2 mil

Oil at 100 bbl

Total Depth -----

PRODUCTION

1st 24 hrs. Nat. _____

1st 24 hrs. after shot-----

Gas _____ Cu. Ft.

Dry Hole.....

Abandoned -----

Date JAN 13 1917

191

E. H. WEST

Scout


BUTLER

Map No. K 11 Sec. 9 Twp. 29 R. 4Well No. 2 Minor FarmOhio Oil Company

NORTH

WEST

EAST

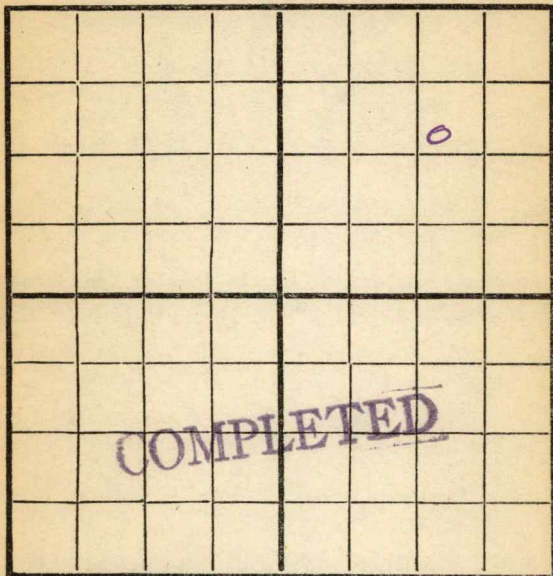

SOUTH

Location -----

Rig Up -----

Drilling and remarks

Cardiff well
Carry production

RECORD

Cased ----- in. ----- Ft.

Sand -----

Gas 1771 - 1777Oil 1783 - 1798Total Depth 1798

PRODUCTION

1st 24 hrs. Nat. 300

1st 24 hrs. after shot -----

Gas 1/2 mil. Cu. Ft.

Dry Hole -----

Abandoned -----

Date

JAN 20 1917

191

E. H. WEST

Scout