

KANSAS

Ellsworth

FORM 51 IOM 12-46 PETROL

Section 31 Township 17 Range 10-W

Well No. 14 Grizzell

Company Gulf

Bloomer Pool

NORTH

						0	

WEST

EAST

SOUTH

KANSAS

Ellsworth

Sec. 31 Twp. 17 R. 10W

Well No. #14 Grizzell Farm _____

_____ Gulf _____ Company

Bloomer Pool


990 Ft. from N. Line

_____ Ft. from S. Line

990 Ft. from E. Line

_____ Ft. from W. Line

SW NE NE

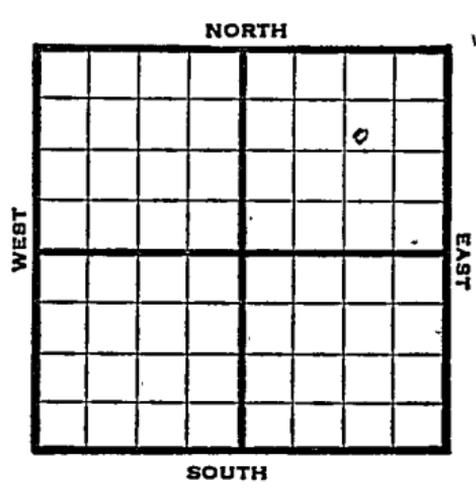

1947	Elev. 1804' REPORT
10/8	Location
10/15	10" @ 368' WOC
10/22	Drlg. 2650'
10/29	Arbuckle 3250' TD 3252 5" @ 3251' RUST
11/4	TD 3261' 500 acid Swab 23½ bbls. oil 24 hrs.
11/12	"
11/19	"
11/25	"
12/3	Arbuckle 3250' 5" @ 3251' Acid 500 Pump 67 oil Pot Gr. 420 Total Depth 3261' COMPLETED

Map No. _____ Sec. 31 Twp. 17 R. 10W

Well No. 14 Grizzell

Gulf Company

FIRST REPORT

Contractor _____

SW NE NE

SECTION PLAT

990 Ft. from N. Line

_____ Ft. from S. Line

990 Ft. from E. Line

_____ Ft. from W. Line

			o

Ellsworth County

Location X

Rig up _____

Drilling and Remarks:

RECORD

Cased _____ in., _____ ft.

Sand _____

Gas _____

Oil _____

Total Depth _____

PRODUCTION

1st 24 hrs. Nat. _____

1st 24 hrs. after shot _____

Gas _____ Cu. Ft.

Dry Hole _____

Abandoned _____

Date

OCT 8 1947 19

S. J. LEWIS Scout

